LAND CORNER RECORDATION CERTIFICATE
Filing Requirement of Act 74, Mich. P.A. 1970 as Amended

For corners in

Houghton
(County)

		Located In:	Corner Code #
1. Public Land Survey		T 52N R 35W	C2
		T___ R___	
		T___ R___	
	S___	T___ R___	
2. Property Controlling	S___	T___ R___	
in Section	S___	T___ R___	
3. Miscellaneous	S___	T___ R___	
Property in Sec.	S___	T___ R___	

Register of Deeds Stamp & File Number

4. Lot No. _____ , Recorded Plat_____
5. Private Claims

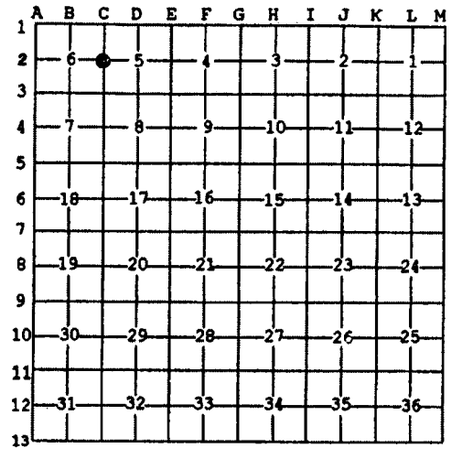

Jun 14 2007

I, Stephan J. Szyszkoski, in a field survey on _____, 20 ____ do hereby state that under requirements of P.A. 74, Michigan P.A. of 1970, the corner points mentioned in lines 1 and 2 above were in conformance with regulations and rules therefore as required in the current manual of survey instructions of the United States Department of the Interior, Bureau of Land Management or by a decree of a Court of Law and /or that the corner points mentioned in lines 3, 4 and 5 above were in conformance with the rules of the Michigan Board of Land Surveyors or by a Decree of a Court of Law; established, re-established, monumented, recovered, found as expressed below:

NOTE: Not more than 2 corners, all in the same town and range, may be recorded on this certificate.

A. Description of original monument and accessories and/or subsequent restoration:

(C2) Quarter corner common to Sections 5-6. 1957 - Remonumented by Billy D. Buckler RLS from one W.Pine B.T. bearing S58E 47 links, stump in good condition. Set 1" pipe with 4" brass cap. 14" Y.Birch N60E 85 links, 14" Cedar S40E 35 links.

B. Description of corner evidence found and/or method applied in restoring or reestablishing corner:

(C2) Found the 1957 monument in good condition. The monument was not found at the record position for the corner. It appears that the true corner position could not be precisely monumented in 1957 due to an underground obstruction which prevented the installation of the monument at the correct location. The monument was found 2.6' west and 0.6' south of the position for the corner as determined from both of the 1957 NBTs, found in good condition, and by the stump of the original BT W.Pine, still in place. The underground obstruction (large log) was removed and a new monument installed at the proper position for the corner. Removed the 1957 monument.

C. Description of monument for corner and accessories established to perpetuate locating the position of the corner:

(C2) Set 1"IDx32" I.pipe with 4" alum.
MDNR cap. Set measuring nails in:
18" Y.Birch N66E 56.6' old blazes *
18" Cedar S41E 24.0' scribing vis. *
6" Maple S09W 22.65' mrkd "1/4S NBT"
9" Y.Birch N37W 8.3' do
Set s'qd spruce post adjacent. Bearings are magnetic. Distances are to nail with MDNR tag. * denotes 1957 NBT.

STATE OF MICHIGAN
STEPHAN J. SZYSZKOSKI
LAND SURVEYOR
No. 33986
LICENSED LAND SURVEYOR

Signed by Stephen J. Szyszkoski Date 7/12/07

Surveyor's Michigan License No 33986

For the Michigan Department of Natural Resources, Office of Land and Facilities

FORM APPROVED BY MICHIGAN STATE BOARD OF PROFESSIONAL SURVEYORS, JAN. 28, 1971
Revised May 14, 1975
Revised Jan., 1983
Rervised Oct., 1995