

LAND CORNER RECORDATION CERTIFICATE
Filing Requirement of Act 74, Mich. P.A. 1970 as Amended

For corners in

<u>Houghton</u> (County)	Located In:	Corner Code #
1. Public Land Survey	T 52N R 35W	G9
	T 52N R 35W	F9
2. Property Controlling in Section	S _____ T _____ R _____	_____
	S _____ T _____ R _____	_____
3. Miscellaneous Property in Sec.	S _____ T _____ R _____	_____
	S _____ T _____ R _____	_____
4. Lot No. _____, Recorded Plat _____		
5. Private Claims		

Register of Deeds Stamp & File Number

	A	B	C	D	E	F	G	H	I	J	K	L	M
1													
2	6		5		4		3		2		1		
3													
4	7		8		9		10		11		12		
5													
6	18		17		16		15		14		13		
7													
8	19		20		21		22		23		24		
9													
10	30		29		28		27		26		25		
11													
12	31		32		33		34		35		36		
13													

I, Stephan J. Szyszkoski, in a field survey on G9 11/09/2009 do hereby state that under requirements of P.A. 74, Michigan P.A. of 1970, the corner points mentioned in lines 1 and 2 above were in conformance with regulations and rules therefore as required in the current manual of survey instructions of the United States Department of the Interior, Bureau of Land Management or by a decree of a Court of Law and /or that the corner points mentioned in lines 3, 4 and 5 above were in conformance with the rules of the Michigan Board of Land Surveyors or by a Decree of a Court of Law; established, re-established, monumented, recovered, found as expressed below:

NOTE: Not more than 2 corners, all in the same town and range, may be recorded on this certificate.

A. Description of original monument and accessories and/or subsequent restoration:

(G9) Corner common to Sections 21-22-27-28. 1846 - Established by S.W.Higgins, Deputy Surveyor. Set post. Sugar 10" S80E 60 links, Maple 12" N50W 20 links. Notes of P.A. and M.C.Larsen: 1925 - "A birch stdg S.E. B.T. marks visible but not called for in field notes". 1953 - Dean C. DeLaMater RLS reestablished the corner by double proportionate measurement. No original evidence at corner. Set 1" pipe with 4" brass cap. 10" Hemlock N63W 38 links, 12" Hemlock S05E 11 links.

(F9) Quarter corner common to Sections 21 and 28. 1846 - Established by S.W.Higgins, Deputy Surveyor. Set post. Y.Birch 11" N35W 41 links, Sugar 13" S78E 6 links. Notes of P.A. and M.C.Larsen: 1925 - B.T. Birch stub burnt stdg - Set stake from same. 1980 - K.L.Sackett RLS found old post set by M.C.Larsen at intersection of blazed lines. Set 1"IDx30" Iron pipe with 4" aluminum cap. 10" Elm North 9.4', 18" Sugar S49W 12.8', 16" Sugar N29E 21.5'.

B. Description of corner evidence found and/or method applied in restoring or reestablishing corner:

(G9) Found the 1953 monument in good condition and at record bearing and distance from the 1953 Hemlock NBTs, both in good condition with overgrown blazes. Found monumented corners 2660.41' north, 2691.22' west, 2643.55' east, and approx. 2641' south. 1953 field notes located at the MI Dept. of Natural Resources office in Baraga suggest that the "double proportionate measurement" referred to in the 1953 record may have been based, in part, on the distances to stream calls given in the original record.

(F9) Found the 1980 monument in good condition and at record bearing and distance from the 1980 witnesses. The Sugar SW is in good condition with overgrown blazes, the Elm North is dead and down, the Sugar NE is a rotting cut stump. Accepted the monument as a careful and faithful perpetuation of the position of the original corner.


C. Description of monument for corner and accessories established to perpetuate locating the position of the corner:

(G9) Found 1"ID I.pipe with 4" brass MI Dept. of Conservation cap. Set measuring nail with MDNR tag in the side of:
 16" Hemlock S05E 7.6' old blaze 1953 NBT
 18" Hemlock N61W 25.6' do do
 8" Sugar N68E 30.3' mrkd "S22 NBT"
 6" Sugar N10W 20.4' "S21 NBT"
 Set sq'd Cedar post adjacent.
 Bearings are magnetic.

(F9) Found 1"ID I.pipe with 4" alum. MDNR cap. Set measuring nail with MDNR tag in the side of:
 20" Sugar S52W 13.0' old blazes 1980 NBT
 12" Hemlock N04E 13.9' mrkd "1/4S NBT"
 4" Maple N80E 2.7' do
 5" Sugar S59E 13.1' do
 Set sq'd cedar post adjacent.
 Bearings are magnetic.

Signed by Stephan J. Szyszkoski
 Surveyor's Michigan License No. 33986

Date 11/17/2009

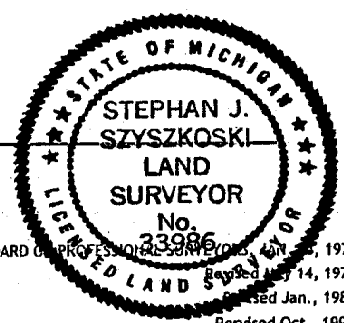

For the Michigan Department of Natural Resources, Office of Land and Facilities

16355
16353