

LAND CORNER RECORDATION CERTIFICATE
Filing Requirement of Act 74, Mich. P.A. 1970 as Amended

For corners in

<u>Houghton</u> (County)	Located In:	Corner Code #
1. Public Land Survey	T 52N R 35W	G8
	T 52N R 35W	F11
2. Property Controlling in Section	T _____ R _____	_____
	S _____ T _____ R _____	_____
	S _____ T _____ R _____	_____
3. Miscellaneous Property in Sec.	S _____ T _____ R _____	_____
	S _____ T _____ R _____	_____
4. Lot No. _____, Recorded Plat _____		
5. Private Claims _____		

Register of Deeds Stamp & File Number

	A	B	C	D	E	F	G	H	I	J	K	L	M
1													
2		6		5		4		3		2		1	
3													
4		7		8		9		10		11		12	
5													
6		18		17		16		15		14		13	
7													
8		19		20		21	●	22		23		24	
9													
10		30		29		28		27		26		25	
11							●						
12		31		32		33		34		35		36	
13													

I, Stephan J. Szyszkoski, in a field survey on G8 11/09/2009 do hereby state that under requirements of P.A. 74, Michigan P.A. of 1970, the corner points mentioned in lines 1 and 2 above were in conformance with regulations and rules therefore as required in the current manual of survey instructions of the United States Department of the Interior, Bureau of Land Management or by a decree of a Court of Law and /or that the corner points mentioned in lines 3, 4 and 5 above were in conformance with the rules of the Michigan Board of Land Surveyors or by a Decree of a Court of Law; established, re-established, monumented, recovered, found as expressed below:

NOTE: Not more than 2 corners, all in the same town and range, may be recorded on this certificate.

A. Description of original monument and accessories and/or subsequent restoration:

(G8) Quarter corner common to Sections 21 and 22. 1953 - Reestablished by Dean C. DeLaMater RLS by proportionate measurement. Examination of the 1953 field notes located at the MI Dept. of Natural Resources office in Baraga indicate that the corner position was prorated to the original record between streams 2.44 chains (record) South, and 4.0 chains (record) North. Set 1" pipe with 4" Brass cap. 10" Hemlock S82E 4 links, 9" W.Pine N15E 39 links.

(F11) Quarter corner common to Sections 28-33. 1846 - Established by S.W.Higgins Deputy Surveyor. Set post. Y.Birch 8" N10E 23 links, Balsam 9" S25W 10 links. Notes of P.A. and M.C.Larsen: "1925 - B.T. Sugar SE stdg - Set Hwd post from same". 1953 - Remonumented by Dean C. DeLaMater RLS from original B.T., in fair condition. Set 1"ID I.pipe with 4" brass cap. 16" H.Maple S55W 58 links, 14" Hemlock N32E 53 links.

B. Description of corner evidence found and/or method applied in restoring or reestablishing corner:

(G8) Found the 1954 monument in good condition and at record bearing and distance from the 1954 witness trees. The W.Pine is a dead stub with scribing visible. The Hemlock is dead and down, the measuring notch visible on the stump, bearing found to be N78W. This monument is 3061.73' South and 2660.41' North of adjacent Section corners G7 and G9. This monument has been in place for 56 years and I accept same as a reestablishment of the position of the original corner.

(F11) Found the 1953 monument in good condition and at record bearing and distance from the 1953 H.Maple NBT, in good condition with overgrown blazes. The original Y.Birch B.T. is a rotting stub with iron marks, at record bearing and distance. Accepted the monument as a careful and faithful perpetuation of the position of the original corner.


C. Description of monument for corner and accessories established to perpetuate locating the position of the corner:

(G8) Found 1"ID I.pipe with 4" brass MI Dept. of Conservation cap. Set measuring nail with MDNR tag in the side of:
 7" Sugar S82E 6.0' mrkd "1/4S NBT"
 7" Y.Birch S09E 16.7' do
 12" Hemlock S78W 13.9' do
 8" Maple N09W 14.7' do
 Set sq'd Cedar post adjacent.
 Bearings are magnetic.

(F11) Found 1"ID I.pipe with 4" brass MI Dept. of Conservation cap. Set measuring nail with MDNR tag in the side of:
 18" Sugar S54W 38.6' old blazes 1953 NBT
 6" Sugar S86E 20.25' mrkd "1/4S NBT"
 11" Maple S03W 12.1' do
 9" Sugar N14W 16.1' do
 Sq'd Cedar post adjacent.
 Bearings are magnetic.

Signed by Stephan J. Szyszkoski
 Surveyor's Michigan License No. 33986

Date 11/17/2009

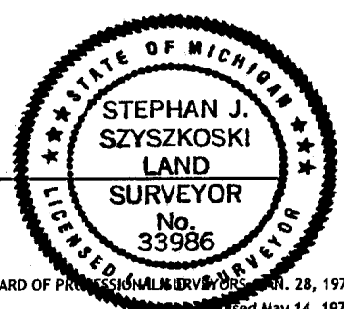

For the Michigan Department of Natural Resources, Office of Land and Facilities