

STATE OF MICHIGAN
DEPARTMENT
OF
NATURAL RESOURCES

LAND CORNER RECORD


Houghton COUNTY
T 52N R 35W

DESCRIPTION OF CORNER 1/4 corner between Sections 25 and 26

CORNER MONUMENT 1" I.D. x 36" iron pipe with 4" aluminum cap.

DATE MONUMENT PLACED AND WITNESSED June 6, 1972

WITNESSES TO CORNER..... Sugar Maple 10 S 2°W (mag.) 13.6 ft. "1/4S, NBT"

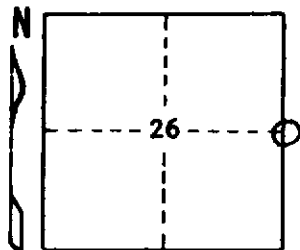

Sugar Maple 4 N55°W (mag.) 16.9 ft. "1/4S, NBT"

AND

CIRCLE CORNER REGISTERED

DESCRIPTION IN DETAIL AS TO HOW CORNER WAS LOCATED AND IDENTIFIED OR RESTORED.

Corner re-established on line between section corners 39.840 ch. to
N and to S.

SURVEYOR'S SEAL

DISTRIBUTION:

Forestry Division, Lansing

Area Forester

District Surveyor

SIGNED

Arthur O. Enger
REGISTERED LAND SURVEYOR

Arthur O. Enger

DATE

July 21, 1972