

Houghton Co.

LAND CORNER RECORDATION CERTIFICATE

FILING REQUIREMENT OF ACT 74, MICH. P.A. 1970

FOR CORNERS OF--:	LOCATED IN--:	CORNER CODE NUMBER
1. PUBLIC LAND SURVEY _____ T. _____ N. S., R. _____ E. W.		
2. PROPERTY CONTROLLING IN SECTION <u>35</u> , T. <u>52</u> N. S., R. <u>35</u> E. W.		<u>8, 9 & 12</u>
3. MISCELLANEOUS PROPERTY IN SECTION _____ , T. _____ N. S., R. _____ E. W.		
4. LOT NO. _____ , RECORDED PLAT _____		
5. PRIVATE CLAIMS _____		

REGISTER OF DEEDS STAMP AND FILING NUMBER

I, Keith L. Sackett, do hereby certify that under requirements of P.A. 74, Michigan P.A. of 1970, the corner points mentioned in lines 1 and 2 above were, in a field survey on June 26, 1978, established, re-established, monumented, re-monumented, recovered or restored as expressed below and in conformance with regulations and rules therefore as required in the current manual of survey instructions of the United States Department of the Interior, Bureau of Land Management or by a decree of a court of law. Furthermore, that the corner points mentioned in lines 3, 4 and 5 above were, in a field survey on _____, 19____, found, recovered, restored, established or re-established as expressed below and in conformance with the rules of the Michigan State Board of Registration for Land Surveyors or, by a Decree of a Court of law:

- A. Description of original monument and accessories and/or subsequent restoration:
- Corner 8: Not Set on Original Survey Nor Subsequently Apparently.
 - Corner 9: Not Set on Original Survey Nor Subsequently Apparently.
 - Corner 12: Not Set on Original Survey Nor Subsequently Apparently.

- B. Description of corner evidence found and/or method applied in restoring or re-establishing corner:
- Corner 8: Established on subdivision of section.
 - Corner 9: Established on subdivision of section.
 - Corner 12: Established on subdivision of section.

- C. Description of monument for corner and accessories established to perpetuate locating the position of the corner:
- Corner 8: Set 1" I.D. x 36" Iron Pipe with 4" aluminum cap. 4" Yellow Birch N48E 13.1 ft. 1/16S BT
12" Squared Yellow Birch West 1.4 ft.
 - 6" Maple N22E 10.2 ft. 1/16S BT
 - 7" Maple N71W 11.9 ft. 1/16S BT
 - 9" Maple S80E 22.5 ft. 1/16S BT
 - Corner 9: Set 1" I.D. x 36" Iron Pipe with 4" aluminum cap. 5" Yellow Birch N53E 6.1 ft. 1/16S BT
8" Sugar S30E 17.0 ft. 1/16S BT
 - 6" Sugar N53W 16.5 ft. 1/16S BT
 - 5" Sugar S37E 15.5 ft. 1/16S BT
 - 4" Squared Birch N51E 1.6 ft.

SIGNED BY _____ DATE _____


SURVEYOR'S MICHIGAN REGISTRATION NO. _____ (SEAL)

FOR STATE AND UNITED STATES AGENCIES:

SIGNED BY _____ DATE _____

APPROVED AND SIGNED BY Keith L. Sackett DATE July 17 1978

CHIEF OF SURVEY PARTY
MICHIGAN REGISTERED LAND SURVEYOR
Keith L. Sackett
Department of Natural Resources

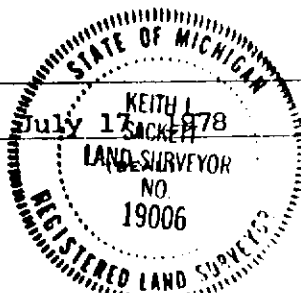

SURVEYOR'S MICHIGAN REGISTRATION NO. 19006