

LAND CORNER RECORDATION CERTIFICATE
Filing Requirement of Act 74, Mich. P.A. 1970

For corners in

Houghton

(County)

Located in:

Corner Code #

1. Public Land Survey	T	<u>52N</u>	R	<u>36W</u>	<u>G8</u>
	T	<u>52N</u>	R	<u>36W</u>	<u>G7</u>
2. Property Controlling in Section	T	_____	R	_____	_____
	T	_____	R	_____	_____
	S	_____	T	_____	_____
3. Miscellaneous Property in Sec.	S	_____	T	_____	_____
	S	_____	T	_____	_____
	S	_____	T	_____	_____

Register of Deeds Stamp & File Number

4. Lot No. _____, Recorded Plat _____
 5. Private Claims _____

Jun 25 2002

I, Stephan J. Szyszkoski, in a field survey on _____, 20____ do hereby state that under requirements of P.A. 74, Michigan P.A. of 1970, the corner points mentioned in lines 1 and 2 above were in conformance with regulations and rules therefore as required in the current manual of survey instructions of the United States Department of the Interior, Bureau of Land Management or by a decree of a Court of Law and/or that the corner points mentioned in lines 3, 4 and 5 above were in conformance with the rules of the Michigan Board of Land Surveyors or by a Decree of a Court of Law, established, re-established, monumented, recovered, found as expressed below:

NOTE: Not more than 2 corners, all in the same town and range, may be recorded on this certificate.

A	B	C	D	E	F	G	H	I	J	K	L	M
2	6	5	4	3	2	1						
3												
4	7	8	9	10	11	12						
5												
6	18	17	16	15	14	13						
7												
8	19	20	21	22	23	24						
9												
10	30	29	28	27	26	25						
11												
12	31	32	33	34	35	36						
13												

A. Description of original monument and accessories and/or subsequent restoration:

(G8) Quarter corner common to Sections 21-22. 1846: Established by S.W.Higgins: " North...40.00 Set 1/4 Sec post. Sugar 36 N50E 18, Hemlock 10 S30W 27". 1904: W.W.Stockley (notes in fieldbook 24, call no. TA 549 V.50-56 .S8 Arch, Michigan Technological University Archives) shows measurements to section corners 42.53' ch. S'yly, 40.25 ch. N'yly, and to 1/4 corner I8 79.09 ch. E'yly. Monuments not described. 1963: Billy D. Buckler found 2" iron pipe "as set by M.C.Larson, Hancock. No original evidence at this time. 7" H.Maple S34W 29 links, 6" H.Maple N87E 26 links".

(G7) Corner common to Sections 15-16-21-22. 1846: Established by S.W.Higgins. 1963: Remonumented by Billy D. Buckler: "This corner was replaced from wood post found by Copper Range Co. who found Hemlock B.T. No original evidence now. Corner checks good with stream to South and West". 1" iron pipe with 4" aluminum cap. 7" Hemlock N21E 38 links, 14" Hemlock S28E 32 links." Also, 1904 notes by W.W.Stockley found in fieldbook 24, Michigan Tech. Archives call no. TA 549 V.50-56 .S8 Arch, show distance south to 1/4 corner 40.25 chains. No monument descriptions.

B. Description of corner evidence found and/or method applied in restoring or reestablishing corner:


(G8) The original post and accessories were not recovered. Found a 2" ID iron pipe, projecting 16" a.g., set firmly, at record bearing and distance from the 1963 witnesses, both in good condition, now 10" and 9" DBH, respectively, and with upper and lower blazes overgrown. Measurements to section corners N'yly 40.157 ch, S'yly 42.470 ch, and 1/4 corner I8 78.964 ch. are consistent in proportion to the 1904 record. I accept the pipe as the best available evidence of the position of the original corner. Made two new witnesses as described below.

(G7) Found the 1963 monument, as described, in good condition, at record bearing and distance from the 1963 witnesses, both in good condition, now 15" and 18" DBH, respectively, with overgrown blazes. Distance south to 1/4 corner is 40.157 chains, in reasonable agreement with Stockley (see also G8 recorded this date). Accepted the monument as the best available evidence of the position of the original corner and made two new witnesses as described below.

C. Description of monument for corner and accessories established to perpetuate locating the position of the corner:

(G8) Found 2" ID I.pipe, projecting 16" a.g. The 1963 accessories are in place and in good condition. Blazed and scribed the following:
 7" twin Sugar N72W 33.1' "1/4S NBT"
 5" Sugar N02E 19.9' do
 Distances are to notch in lower blaze.
 A 6' tall cedar post with State Forest sign bears S25W, 3.3' distant. Bearings are magnetic.

(G7) Found 1" ID I.pipe with 4" Alum. MI Dept. of Conservation cap. The 1963 witnesses are in place and in good condition. Blazed and scribed:
 7" Sugar N44W 40.0' "S16 NBT"
 14" Hemlock N04W 32.9' do
 Set squared cedar post adjacent.
 Bearings are magnetic. Distances are to notch in lower blaze.

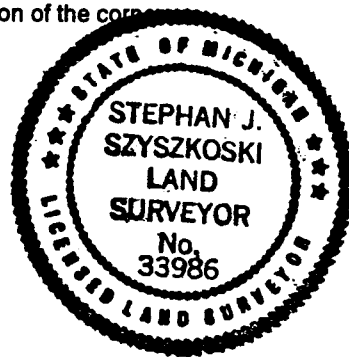

Signed by Stephan J. Szyszkoski
 Surveyor's Michigan License No. 33986

Date 7/17/02