

LAND CORNER RECORDATION CERTIFICATE
Filing Requirement of Act 74, Mich. P.A. 1970

For corners in

<u>Houghton</u> (County)	Located In:	Corner Code #
1. Public Land Survey	T ___ R ___	_____
	T ___ R ___	_____
	T ___ R ___	_____
	T ___ R ___	_____
2. Property Controlling in Section	S <u>21</u> T <u>52N</u> R <u>36W</u>	<u>13</u>
	S <u>21</u> T <u>52N</u> R <u>36W</u>	<u>1/64 E. of F8</u>
3. Miscellaneous Property in Sec.	S ___ T ___ R ___	_____
	S ___ T ___ R ___	_____

Register of Deeds Stamp & File Number

4. Lot No. _____, Recorded Plat _____
 5. Private Claims _____

Jun 26 2003

I, Stephan J. Szyszkoski, in a field survey on _____, 20____ do hereby state that under requirements of P.A. 74, Michigan P.A. of 1970, the corner points mentioned in lines 1 and 2 above were in conformance with regulations and rules therefore as required in the current manual of survey instructions of the United States Department of the Interior, Bureau of Land Management or by a decree of a Court of Law and /or that the corner points mentioned in lines 3, 4 and 5 above were in conformance with the rules of the Michigan Board of Land Surveyors or by a Decree of a Court of Law; established, re-established, monumented, recovered, found as expressed below:

NOTE: Not more than 2 corners, all in the same town and range, may be recorded on this certificate.


1	A	B	C	D	E	F	G	H	I	J	K	L	M
2		6		5		4		3		2		1	
3													
4		7		8		9		10		11		12	
5													
6		18		17		16		15		14		13	
7													
8		19		20		21		22		23		24	
9													
10		30		29		28		27		26		25	
11													
12		31		32		33		34		35		36	
13													

A. Description of original monument and accessories and/or subsequent restoration:
 (13-Sec. 21) Southeast 1/16 corner, Section 21. Not established in the original survey.
 (1/64 E. of F8) C-W-E 1/64 corner, Section 21, being between F8 and the Center-East 1/16 corner. Not established in the original survey.

B. Description of corner evidence found and/or method applied in restoring or reestablishing corner:
 (13-Sec. 21) Established the corner at the intersection of straight lines connecting opposite 1/16 corners.
 (1/64) Established the corner midway and on a straight line between Center of Section 740.18' West and 1/16 corner 740.18' East.

C. Description of monument for corner and accessories established to perpetuate locating the position of the corner:

(13) Set 1"IDx32" I.pipe with 4" alum. MDNR cap. Blazed, scribed, and set measuring nails in: 9" Cedar N52E 7.1' "1/16S 8T" 4" Cedar S66E 10.0' do 8" Cedar S16W 23.1' do 6" Hemlock N86W 37.9' do Set squared cedar post adjacent. Bearings are magnetic. Distances are to nail with tag.	(1/64) Set 1"IDx32" I.pipe with 4" alum. MDNR cap. Blazed, scribed, and set measuring nails in: 14" Maple N33E 3.5' "1/64S 8T" 13" Sugar S51E 21.8' do 11" Hemlock S35E 27.6' do 10" Sugar S85W 13.2' do Set squared cedar post adjacent. Bearings are magnetic. Distances are to nail with tag.
--	--

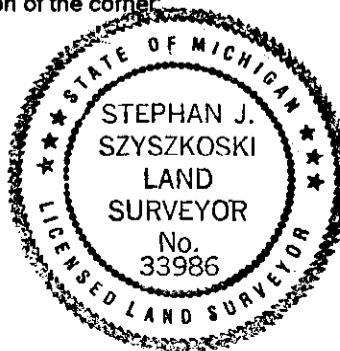

Signed by Stephan J. Szyszkoski Date 7/14/2003
 Surveyor's Michigan License No. 33986