

**LAND CORNER RECORDATION CERTIFICATE**  
**Filing Requirement of Act 74, Mich. P.A. 1970 as Amended**

For corners in

<u>Houghton</u> <small>(County)</small>	Located In:	Corner Code #
1. Public Land Survey	T _____ R _____ T _____ R _____ T _____ R _____	_____
2. Property Controlling in Section	S <u>28</u> T <u>52N</u> R <u>36W</u> S _____ T _____ R _____	<u>1</u> _____
3. Miscellaneous Property in Sec.	S _____ T _____ R _____ S _____ T _____ R _____	<u>3</u> _____
4. Lot No. _____, Recorded Plat _____		
5. Private Claims		

Register of Deeds Stamp & File Number

1	A	B	C	D	E	F	G	H	I	J	K	L	M
2	6		5		4		3		2		1		
3													
4	7		8		9		10		11		12		
5													
6	18		17		16		15		14		13		
7													
8	19		20		21		22		23		24		
9													
10	30		29		28		27		26		25		
11													
12	31		32		33		34		35		36		
13													

I, Stephan J. Szyszkoski, in a field survey on Nov. 13, 2007 do hereby state that under requirements of P.A. 74, Michigan P.A. of 1970, the corner points mentioned in lines 1 and 2 above were in conformance with regulations and rules therefore as required in the current manual of survey instructions of the United States Department of the Interior, Bureau of Land Management or by a decree of a Court of Law and /or that the corner points mentioned in lines 3, 4 and 5 above were in conformance with the rules of the Michigan Board of Land Surveyors or by a Decree of a Court of Law; established, re-established, monumented, recovered, found as expressed below:

**NOTE: Not more than 2 corners, all in the same town and range, may be recorded on this certificate.**

A. Description of original monument and accessories and/or subsequent restoration:

(1-Sec. 28) West 1/16 corner between Sections 21 and 28. Not established in the original survey.

(3-Sec. 28) North 1/16 corner between Sections 28 and 29. Not established in the original survey.

B. Description of corner evidence found and/or method applied in restoring or reestablishing corner:

(1-Sec. 28) Established the corner midway and on the Section line between Section corner 1341.66' west and Quarter corner 1341.66' east.


(3-Sec. 28) Established the corner midway and on the Section line between Section corner 1293.73' north and Quarter corner 1293.73' south.

C. Description of monument for corner and accessories established to perpetuate locating the position of the corner:

(1) Set 1"IDx32" I.pipe with 4" alum. MDNR cap.  
 Set measuring nail with MDNR tag in the side of:  
 4" double Maple N30E 3.55' mrkd "1/16S BT"  
 6" Y.Birch N84E 12.5' do  
 7" Hemlock S49E 17.25' do  
 4" triple Oak S05E 7.65' do  
 Set sq'd cedar post adjacent. Bearings are magnetic.

(3) Set 1"IDx32" I.pipe with 4" alum. MDNR cap.  
 Set measuring nail with MDNR tag in the side of:  
 8" Maple N36W 23.3' mrkd "1/16S BT"  
 7" Y.Birch N44E 19.9' do  
 4" Sugar S20E 16.5' do  
 5" Y.Birch S50W 17.1' do  
 Set sq'd cedar post adjacent. Bearings are magnetic.

Signed by Stephan J. Szyszkoski

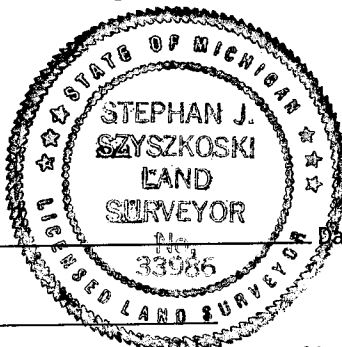

Date 12/17/07

Surveyor's Michigan License No. 33986

For the Michigan Department of Natural Resources, Office of Land and Facilities