

LAND CORNER RECORDATION CERTIFICATE
Filing Requirement of Act 74, Mich. P.A. 1970 as Amended

For corners in

<u>Houghton</u> (County)	Located In:	Corner Code #
1. Public Land Survey	T <u>52N</u> R <u>36W</u>	<u>B9</u>
	T _____ R _____	_____
	T _____ R _____	_____
2. Property Controlling in Section	S <u>28</u> T <u>52N</u> R <u>36W</u>	<u>15</u>
	S _____ T _____ R _____	_____
	S _____ T _____ R _____	_____
3. Miscellaneous Property in Sec.	S _____ T _____ R _____	_____
	S _____ T _____ R _____	_____
4. Lot No. _____, Recorded Plat _____		
5. Private Claims		

Register of Deeds Stamp & File
Number

A	B	C	D	E	F	G	H	I	J	K	L	M
1												
2	6	5	4	3	2	1						
3												
4	7	8	9	10	11	12						
5												
6	18	17	16	15	14	13						
7												
8	19	20	21	22	23	24						
9	●											
10	30	29	28	27	26	25						
11			●									
12	31	32	33	34	35	36						
13												

I, Stephan J. Szyszkoski, in a field survey on _____, 2007 do hereby state that under requirements of P.A. 74, Michigan P.A. of 1970, the corner points mentioned in lines 1 and 2 above were in conformance with regulations and rules therefore as required in the current manual of survey instructions of the United States Department of the Interior, Bureau of Land Management or by a decree of a Court of Law and /or that the corner points mentioned in lines 3, 4 and 5 above were in conformance with the rules of the Michigan Board of Land Surveyors or by a Decree of a Court of Law; established, re-established, monumented, recovered, found as expressed below:

NOTE: Not more than 2 corners, all in the same town and range, may be recorded on this certificate.

A. Description of original monument and accessories and/or subsequent restoration:

(B9) Quarter corner common to Sections 19 and 30. 1846 - Established by S.W.Higgins, Deputy Surveyor, on the Section line between Section corners 40.60 chains west and 40.00 chains east. Set post. Sugar 14 S53W 17 links, Sugar 13 N60E 27 links. Found no subsequent record.

(15-Sec. 28) West 1/16 corner between Sections 28 and 33. Not established in the original survey.

B. Description of corner evidence found and/or method applied in restoring or reestablishing corner:


(B9) The original post and accessories were not recovered. At approximately 230' north and 174' east of the position proportionate to the original record, I found a very old 1 3/4" ID iron pipe, firmly set, projecting about 3 ft, top rusted through, placed by persons unknown, similar in appearance and age to many mining co. monuments previously recovered in this township. My measurements show that the Center of Section 30, an iron pipe monument probably placed by Copper Range Co. surveyors over 60 years ago, was established on the N-S 1/4 line of Section 30 as defined by this 1 3/4" pipe and a pipe at corner B11. Despite the fact that the position of B9 was found at such an extreme deviation from the position described in the original notes (a circumstance which is common in this township due to the large and many defects in the original survey), I note that the pipe here has been in place for a great many years and has been judged by others to be acceptable control for at least one subsequent survey. Therefore I accept the pipe as the best available evidence of the position of the original corner.

(15-Sec. 28) Established the corner midway and on the Section line between Section corner 1337.34' west and Quarter corner 1337.34' east.

C. Description of monument for corner and accessories established to perpetuate locating the position of the corner:

(B9) Found 1 3/4" ID I.pipe, 3 ft. tall, top rusted and broken off. Set measuring nail with MDNR tag in the side of:	(15) Set 1" IDx32" I.pipe with 4" alum. MDNR cap. Set measuring nail with MDNR tag in the side of:
8" Sugar N71E 18.5' mrkd "1/4S NBT"	8" Hemlock N74E 40.3' mrkd "1/16S BT"
6" Sugar S48E 34.0' do	7" Hemlock S13W 14.1' do
10" Y.Birch S12W 59.8' do	12" Maple N86W 12.5' do
12" Sugar N39W 7.8' do	9" Maple N30W 7.5' do
Set Sugar post adjacent. Bearings are magnetic.	Set sq'd cedar post adjacent. Bearings are magnetic.

Signed by Stephan J. Szyszkoski

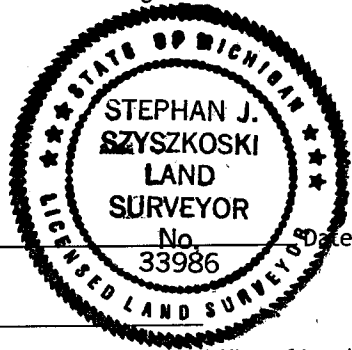

Date 12/17/07

Surveyor's Michigan License No. 33986