

LAND CORNER RECORDATION CERTIFICATE
Filing Requirement of Act 74, Mich. P.A. 1970 as Amended

For corners in

<u>Houghton</u> (County)	Located In:	Corner Code #
1. Public Land Survey	T52N R 36W	C9
	T52N R 36W	J13
	T_____ R_____	_____
	S_____ T_____ R_____	_____
2. Property Controlling in Section	S_____ T_____ R_____	_____
	S_____ T_____ R_____	_____
3. Miscellaneous Property in Sec.	S_____ T_____ R_____	_____
	S_____ T_____ R_____	_____
4. Lot No. _____, Recorded Plat _____		
5. Private Claims		

Register of Deeds Stamp & File Number

	A	B	C	D	E	F	G	H	I	J	K	L	M
1													
2	6		5		4		3		2		1		
3													
4	7		8		9		10		11		12		
5													
6	18		17		16		15		14		13		
7													
8	19		20		21		22		23		24		
9			●										
10	30		29		28		27		26		25		
11													
12	31		32		33		34		35		36		
13										●			

I, Stephan J. Szyszkoski, in a field survey on _____, 2007 do hereby state that under requirements of P.A. 74, Michigan P.A. of 1970, the corner points mentioned in lines 1 and 2 above were in conformance with regulations and rules therefore as required in the current manual of survey instructions of the United States Department of the Interior, Bureau of Land Management or by a decree of a Court of Law and /or that the corner points mentioned in lines 3, 4 and 5 above were in conformance with the rules of the Michigan Board of Land Surveyors or by a Decree of a Court of Law; established, re-established, monumented, recovered, found as expressed below:

NOTE: Not more than 2 corners, all in the same town and range, may be recorded on this certificate.


A. Description of original monument and accessories and/or subsequent restoration:
 (C9) Corner common to Sections 19-20-29-30. 1846 - Established by S.W.Higgins, Deputy Surveyor. Set post. Y.Birch 10 S35W 35 links, Sugar 12 N45E 14 links. Found no subsequent record.
 (J13) Quarter corner common to Section 35 T52N-R36W and Section 2 T51N-R36W. 1845 - Established by Wm.A.Burt, Deputy Surveyor, midway and on the Township line between Section corners 40.00 chains east and west. Set post. Sugar 10 N23E 13 links, Sugar 12 N40W 8 links. Found no subsequent record.

B. Description of corner evidence found and/or method applied in restoring or reestablishing corner:
 (C9) The original post and accessories were not recovered. Found a 1 1/4" ID iron pipe, projecting 14" above ground, set firm, with a 10" Sugar NBT S88W 8.6' facing it. An old yellow location poster is affixed to the tree, a good part of it grown over. No names or dates found. This corner monument conforms well with old iron pipes found at 1/16 corner #7, Sec. 30., 1308.65' south and Quarter corner C10 2615.46' south, the pipe at #7 being 0.08' west of a straight line between C9 and C10. This fact suggests that the pipe has been used to control the location of title lines in this area. I accepted the pipe as the best available evidence of the position of the original corner.

(J13) The original post and accessories were not recovered. Found no evidence of the position of the original corner on the ground. Reestablished the corner midway and on the Township line between Section corners 2627.83' east and west.

C. Description of monument for corner and accessories established to perpetuate locating the position of the corner:
 (C9) Found 1 1/4" ID iron pipe. Set measuring nail with MDNR tag in the side of:
 4" Sugar N60E 13.25' mrkd "S20 NBT"
 4" Sugar S14W 14.85' "S30 NBT"
 10" Sugar S88W 8.55' "S30 NBT"
 11" Sugar N35W 27.35' "S19 NBT"
 Set sq'd cedar post adjacent. Bearings are magnetic.
 (J13) Set 1"IDx32" I.pipe with 4" alum. MDNR cap. Set measuring nail with MDNR tag in the side of:
 5" Sugar S57W 19.60' mrkd "1/4S NBT"
 7" Sugar N50W 29.4' do
 6" Sugar N19E 12.2' do
 5" Hemlock S12W 14.9' do
 Set sq'd cedar post adjacent. Bearings are magnetic.

Signed by Stephan J. Szyszkoski

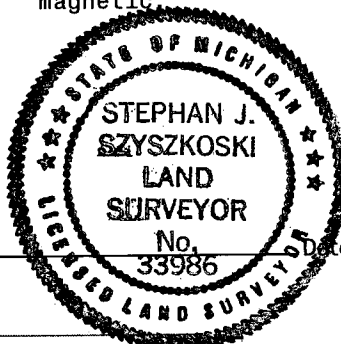

Date 12/17/07

Surveyor's Michigan License No. 33986