

**LAND CORNER RECORDATION CERTIFICATE**  
**Filing Requirement of Act 74, Mich. P.A. 1970 as Amended**

For corners in

<u>Houghton</u> (County)	Located In:	Corner Code #
1. Public Land Survey	<u>T52N R 36W</u>	<u>E11</u>
	T <u>    </u> R <u>    </u>	<u>    </u>
	T <u>    </u> R <u>    </u>	<u>    </u>
2. Property Controlling in Section	<u>S 28</u> T <u>52N</u> R <u>36W</u>	<u>4</u>
	S <u>    </u> T <u>    </u> R <u>    </u>	<u>    </u>
	S <u>    </u> T <u>    </u> R <u>    </u>	<u>    </u>
3. Miscellaneous Property in Sec.	S <u>    </u> T <u>    </u> R <u>    </u>	<u>    </u>
4. Lot No. <u>    </u> , Recorded Plat <u>    </u>		
5. Private Claims		

**Register of Deeds Stamp & File Number**

4 Nov 13 2007  
E11 Sep 27 2007

I, Stephan J. Szyszkoski, in a field survey on     , 2007 do hereby state that under requirements of P.A. 74, Michigan P.A. of 1970, the corner points mentioned in lines 1 and 2 above were in conformance with regulations and rules therefore as required in the current manual of survey instructions of the United States Department of the Interior, Bureau of Land Management or by a decree of a Court of Law and /or that the corner points mentioned in lines 3, 4 and 5 above were in conformance with the rules of the Michigan Board of Land Surveyors or by a Decree of a Court of Law; established, re-established, monumented, recovered, found as expressed below:

**NOTE: Not more than 2 corners, all in the same town and range, may be recorded on this certificate.**

A	B	C	D	E	F	G	H	I	J	K	L	M
1												
2	6		5		4		3		2		1	
3												
4	7		8		9		10		11		12	
5												
6	18		17		16		15		14		13	
7												
8	19		20		21		22		23		24	
9												
10	30		29		28		27		26		25	
11												
12	31		32		33		34		35		36	
13												

A. Description of original monument and accessories and/or subsequent restoration:  
(E11) Corner common to Sections 28-29-32-33. 2000 - remonumented by S.C.Hein PS and recorded in Liber 4 of LCR, Page 170. Set 1/2" capped pin. 8" R.Maple N70E 20.54', 5" H.Maple S44E 27.26', 6" Apple S45W 30.36', 10" H.Maple N53W 25.75'.


(4-Sec. 28) Northwest 1/16 corner, Section 28. Not established in the original survey.

B. Description of corner evidence found and/or method applied in restoring or reestablishing corner:  
(E11) Found the 2000 monument (1/2" rebar with cap missing) bent over but with lower portion plumb and in position, at record bearing and distance from the R.Maple N70E in good condition, from the H.Maple N53W, now a stump, and from the 1963 NBT H.Maple S84E by Billy D. Buckler RLS. Straightened the rebar and drove it to 5" below the surface of the road. I note that the nail set by Mr. Hein in the R.Maple N70E is nearly overgrown. It is about 6" above the ground. Someone has placed another nail in this NBT about 2.5' above the ground. This higher nail is 20.35' from the corner monument. The 2000 NBTs S44E and S45W were not recovered.

(4-Sec. 28) Established the corner at the intersection of straight lines connecting opposite 1/16 corners.

C. Description of monument for corner and accessories established to perpetuate locating the position of the corner:  
(E11) Fd. 1/2" rebar. Drove to 5" below rd. surface. (4) Set 1"IDx32" I.pipe with 4" alum. MDNR cap. 9" Maple N71E 20.5' fd nail 6" above ground Set measuring nail with MDNR tag in the side of:  
Set measuring nail with MDNR tag in the side of: 4" Hemlock N62E 25.4' mrkd "1/16S BT"  
11" Sugar S82E 23.1' scribing vis. (1963 NBT) 8" Sugar S18E 17.5' do  
9" Sugar N42W 46.4' mrkd "S32 NBT" 7" Hemlock S74W 21.65' do  
7" Spruce S76W 36.7' "S29 NBT" 7" Maple N55W 18.05' do  
Bearings are magnetic. Set sq'd cedar post adjacent. Bearings are magnetic.

Signed by Stephan J. Szyszkoski

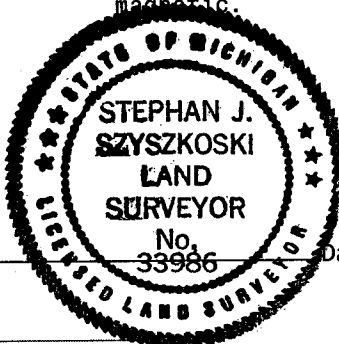

Date 12/17/07

Surveyor's Michigan License No. 33986