

MICHIGAN
DEPARTMENT OF CONSERVATION
FORESTRY DIVISION

LAND CORNER RECORD

T. 52 N.R. 36-37th


Ontonagon-Howenton COUNTY

DESCRIPTION OF CORNER 1/4 Corner between Secs. 19-24

CORNER MONUMENT Wood Post

DATE MONUMENT PLACED AND WITNESSED 5/14/64

WITNESSES TO CORNER..... 14" Hard Maple (2S 1BT) South 63 Ins.

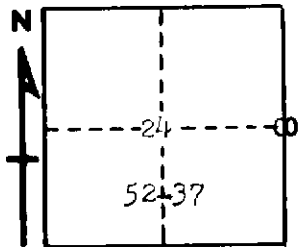

9" Hard Maple (2S 1BT) N72°W 07 Ins.

11" Hard Maple (2S 1BT) N67°E 45 Ins.

AND

CIRCLE CORNER REGISTERED

DESCRIPTION IN DETAIL AS TO HOW CORNER WAS LOCATED AND IDENTIFIED OR RESTORED.

This Corner was re-established by Single Proportionate Measure along Township line from Section Corner $\frac{1}{2}$ mile North and 1/4 Corner 1 mile South. Found old blazes both North and South of Corner. Corner lies 4.00 Chains South of old Grade.

SURVEYOR'S SEAL

SIGNED Billy D. Buckler
BILLY D. BUCKLER
REGISTERED LAND SURVEYOR

DATE 3/5/1964