

MICHIGAN  
DEPARTMENT OF CONSERVATION  
FORESTRY DIVISION

LAND CORNER RECORD

T. 52 N.R. 36-37


Ontonagon-Houghton COUNTY

DESCRIPTION OF CORNER Section Corner common to Secs. 19-30-24-25

CORNER MONUMENT 1" Pipe with 4" Aluminum Cap

DATE MONUMENT PLACED AND WITNESSED 5/14/64

WITNESSES TO CORNER..... 9" Cedar (S30 NBT) S65°E 97 Lks.

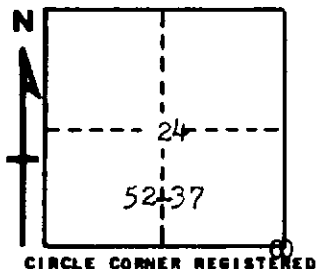

No other available

AND

DESCRIPTION IN DETAIL AS TO HOW CORNER WAS LOCATED AND IDENTIFIED OR RESTORED.

This Corner was re-established by Single Proportionate Measure along Township Line, from Corners  $\frac{1}{2}$  mile South and 1 mile North. Found a Cedar Stump bearing S75°E 49 Links which has been marked as a witness. This mark faces position of the Corner.

SURVEYOR'S SEAL

*Billy D. Buckler*  
SIGNED BILLY D. BUCKLER DATE 8/5/1964  
REGISTERED LAND SURVEYOR