


LAND CORNER RECORDATION CERTIFICATE
Filing Requirement of Act 74, Mich. P.A. 1970

For corners in Houghton (County)	Located In:	Corner Code #
1. Public Land Survey	T 52N R 36W	C4
	T 52N R 36W	D5
	T R	
	T R	
2. Property Controlling in Section	S T R	
	S T R	
3. Miscellaneous Property in Sec.	S T R	
	S T R	

Register of Deeds Stamp & File Number

- 4. Lot No. _____, Recorded Plat _____
- 5. Private Claims _____

I, Stephan J. Szyszkoski, in a field survey on October 18, 1995, 19_____, do hereby certify that under requirements of P.A. 74, Michigan P.A. of 1970, the corner points mentioned in lines 1 and 2 above were in conformance with regulations and rules therefore as required in the current manual of survey instructions of the United States Department of the Interior, Bureau of Land Management or by a decree of a Court of Law and/or that the corner points mentioned in lines 3, 4 and 5 above were in conformance with the rules of the Michigan Board of Land Surveyors or by a Decree of a Court of Law; established, re-established, monumented, re-monumented, recovered, found as expressed below:

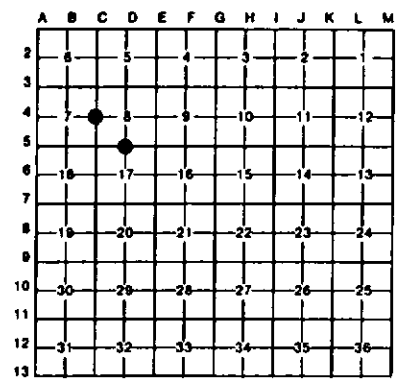

NOTE: Not more than 4 corners, all in the same town and range, may be recorded on this certificate.

A. Description of original monument and accessories and/or subsequent restoration:

(C4) Quarter corner common to Sections 7-8. Corner established in 1846 by Hiram Higgins: "40.00 Set 1/4 Sec post. Ironwood 8 N55W 15, Hemlock 14 S16E 35". Mead records indicate 3/4" iron pipe and 6" squared Cedar Post found in 1960. Further "Cor. is 15 paces SW of a 24" Birch stub on W edge of Poyhonen log road". Found no subsequent record.

(D5) Quarter corner common to Sections 8-17. Corner established in 1846 by Hiram Higgins: "40.00 Set 1/4 Sec post. Sugar 14 N53E 29, Hemlock 13 S40W 32." Original random notes East between 8/17 include "45.00 Stream 2 N in ravine, 51.00 Stream 3 N in ravine..."

B. Description of corner evidence found and/or method applied in restoring or reestablishing corner:

(C4) Original post not recovered. Found a 1 1/2" iron pipe adjacent to a squared cedar post scribed "1/4S". The post was found on the ground, partially rotten. The pipe was found at record bearing and distance from the remains of a Hemlock stump, of proper size to match the original. The stump is well rotted with no markings visible. The Ironwood BT was not recovered. The Birch stub noted by Mead was not recovered but the pipe appears to be in the same position with respect to the log road. Distance south to a reestablished corner is longer than record by about 0.8 chains. This is not unusual for this part of the township. Accepted the pipe as the best available evidence of the position of the original corner, left it in place and marked witnesses as described below.

(D5) Original post and accessories not recovered. Found a 1 1/2" dia. iron pipe with an old blazed beaver on a 10" Hemlock facing it. Distances to the streams to the east check well with the record with the exception that the second stream call noted above does not fall in a ravine. It was found as an old stream bed at the foot of a steep hill. Nearby road construction has possibly diverted water from it. Distances east and west to monumented section corners were found to be 2.34 ch. shorter and 0.14 ch. longer than the original record, respectively. I accepted the pipe as the best available evidence of the position of the original corner.

C. Description of monument for corner and accessories established to perpetuate locating the position of the corner:

(C4) Found 1 1/2" iron pipe.	(D5) Found 1 1/2" iron pipe.
Blazed and scribed the following new bearing trees:	Blazed and scribed the following new bearing trees:
8" Sugar N28W 24.7' "1/4S NBT"	16" Sugar S55W 14.0' "1/4S NBT"
10" Sugar N41E 15.3' "1/4S NBT"	10" Hemlock N70W 19.6' "1/4S NBT"
4" Sugar S22E 19.9' "1/4S NBT"	16" Hemlock N43E 20.8' "1/4S NBT"
6" Sugar S54W 54.4' "1/4S NBT"	8" Sugar S02E 31.9' "1/4S NBT"
Bearings are magnetic.	Bearings are magnetic.



Signed by Stephan J. Szyszkoski Date 10-26-95
 Surveyor's Michigan License No. 33986