

JAN 25 2000

Robert W. Crampton
9/24/99

LAND CORNER RECORDATION CERTIFICATE
Filing Requirement of Act 74, Mich. P.A. 1970

SECTION

For corners in
HOUGHTON
(County)

Located In:

Corner Code #

- | | | | | | |
|--------------------------------------|---|------------|---|------------|--------------|
| 1. Public Land Survey | T | <u>53N</u> | R | <u>32W</u> | <u>B-5</u> ✓ |
| | T | <u>53N</u> | R | <u>32W</u> | <u>B-7</u> |
| | T | _____ | R | _____ | _____ |
| | T | _____ | R | _____ | _____ |
| 2. Property Controlling in Section | S | _____ | T | _____ | _____ |
| | S | _____ | T | _____ | _____ |
| 3. Miscellaneous Property in Section | S | _____ | T | _____ | _____ |
| | S | _____ | T | _____ | _____ |
4. Lot No. _____, Recorded Plat _____
5. Private Claims _____

MARY SCHOOS 09/27/99
HOUGHTON COUNTY, REGISTER 10:11
LC 4/ 29 PAU Fee: 9.00
Page 1 of 1

Register of Deeds Stamp & File Number

I, R.W. CRAMPTON, in a field survey on MAY 27, 1999, do hereby certify that under requirements of P.A. 74, Michigan P.A. of 1970, the corner points mentioned in lines 1 and 2 above were in conformance with regulations and rules therefore as required in the current manual of survey instructions of the United States Department of the Interior, Bureau of Land Management or by a decree of a Court of Law and/or that the corner points mentioned in lines 3, 4 and 5 above were in conformance with the rules of the Michigan Board of Professional Surveyors or by a Decree of a Court of Law; established, re-established, monumented, re-monumented, recovered, found as expressed below:

NOTE: Not more than 4 corners, all in the same town and range, may be recorded on this certificate.

A. Description of original monument and accessories and/or subsequent restoration:

B-5, SET QR. SECTION POST, Y. BIRCH 12 S30W 26, Y. BIRCH 12 NORTH 14.

B-7, SET QR. SECTION POST, HEMLOCK 16 N55W 14, HEMLOCK S59W 20.

B. Description of corner evidence found and/or method applied in restoring or reestablishing corner:

B-5, 1 1/2" IRON PIPE (FND). REPLACED WITH 1" IRON PIPE WITH BRASS CAP.


B-7, 2" SOLID STEEL PIN FOUND 4 FEET NORTH OF CENTERLINE OF COUNTY ROAD T29 AND ON A PROJECTION OF AN OLD STONE WALL AND FENCE NORTH OF THE CORNER.

C. Description of monument for corner and accessories established to perpetuate locating the position of the corner:

*B-5, THE 1" IRON PIPE WITH BRASS CAP WAS WITNESSED WITH SURVEY TAG NAILED TO:
7" BALSAM FIR TREE N44°E 22.26', 11" CEDAR TREE S40°E 31.34',
5" BALSAM FIR TREE S7°W 7.20', 9" BALSAM FIR TREE N52°W 19.90'.*

*B-7, THE 2" STEEL PIN WAS WITNESSED WITH SURVEY TAG NAILED TO:
UTILITY POLE N80°W 92.21', 8" ASPEN TREE NORTH 46.50',
6" CEDAR TREE S20°E 66.36', 6" FIR TREE S60°W 67.88', EAST 158.74' TO A 2" IRON PIPE.*

A	B	C	D	E	F	G	H	I	J	K	L	M
2	6	5	4	3	2	1						
3												
4	7	8	9	10	11	12						
5	•											
6	18	17	16	15	14	13						
7	•											
8	19	20	21	22	23	24						
9												
10	30	29	28	27	26	25						
11												
12	31	32	33	34	35	36						
13												

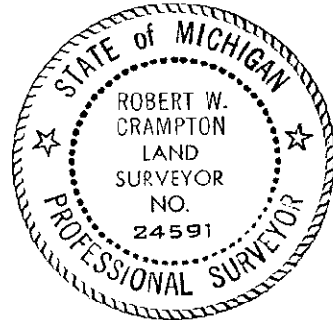

Signed by Robert W. Crampton

Date SEPT. 23, 1999

Surveyor's Michigan License No. 24591