

DEC 14 1998

LAND CORNER RECORDATION CERTIFICATE
Filing Requirement of Act 74, Mich. P.A. 1970

SECTION

For corners in
HOUGHTON
(County)

Located In:

Corner Code #

- | | | | | | |
|--------------------------------------|---|------------|---|------------|------------|
| 1. Public Land Survey | T | <u>53W</u> | R | <u>33W</u> | <u>I-3</u> |
| | T | _____ | R | _____ | _____ |
| | T | _____ | R | _____ | _____ |
| | T | _____ | R | _____ | _____ |
| 2. Property Controlling in Section | S | _____ | T | _____ | _____ |
| | S | _____ | T | _____ | _____ |
| 3. Miscellaneous Property in Section | S | _____ | T | _____ | _____ |
| | S | _____ | T | _____ | _____ |

ROBERT F. MIKESCH 11/16/98
HOUGHTON COUNTY, REGISTER 14:44
LC 3/ 542 PAU Fee: 9.00
Page 1 of 1

Register of Deeds Stamp & File Number

4. Lot No. _____, Recorded Plat _____
5. Private Claims _____

A	B	C	D	E	F	G	H	I	J	K	L	M
2	6	5	4	3	2	1						
3												
4	7	8	9	10	11	12						
5												
6	18	17	16	15	14	13						
7												
8	19	20	21	22	23	24						
9												
10	30	29	28	27	26	25						
11												
12	31	32	33	34	35	36						
13												

I, R. W. CRAMPTON, in a field survey on OCTOBER 30, 19 98, do hereby certify that under requirements of P.A. 74, Michigan P.A. of 1970, the corner points mentioned in lines 1 and 2 above were in conformance with regulations and rules therefore as required in the current manual of survey instructions of the United States Department of the Interior, Bureau of Land Management or by a decree of a Court of Law and/or that the corner points mentioned in lines 3, 4 and 5 above were in conformance with the rules of the Michigan Board of Professional Surveyors or by a Decree of a Court of Law; established, re-established, monumented, re-monumented, recovered, found as expressed below:

NOTE: Not more than 4 corners, all in the same town and range, may be recorded on this certificate.

A. Description of original monument and accessories and/or subsequent restoration:


I-3, SET POST CORNER SECTIONS 2, 3, 10 & 11, TAMARACK 5, S43W 41, TAMARACK 2, N36E 25.

B. Description of corner evidence found and/or method applied in restoring or reestablishing corner:

I-3, SET 1 1/4" IRON PIPE WITH BRASS CAP ON LINE BETWEEN WEST 1/4 CORNER OF SECTION 11, AND THE NW CORNER OF SECTION 2, AT A PROPORTIONED DISTANCE, AND A LINE FROM THE SE CORNER OF SECTION 2 TO THE PROPORTIONED DISTANCE.

C. Description of monument for corner and accessories established to perpetuate locating the position of the corner:

I-3, THE 1 1/4" IRON PIPE WITH BRASS CAP WAS WITNESSED WITH SURVEY TAG NAILED TO:
14" SPRUCE TREE N54°W 52.70', 16" ASPEN N41°E 27.80',
14" SPRUCE TREE S05°E 66.96', 8" TAMARACK TREE S75°W 64.29'.

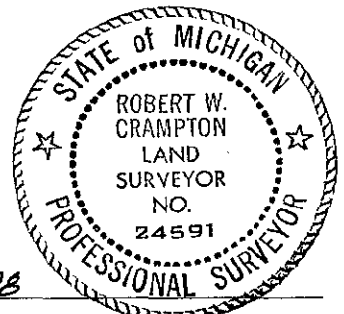

Signed by Robert W. Crampton
Surveyor's Michigan License No. 24591

Date Nov. 6, 1998