APPROVED LAND CORNER
P.A. 345 OF 1990
Houghton County

Nov. 6, 1998
Robert W. Crampton

For corners in
HOUGHTON
(County)

[redacted]

DEC 14 1998

SECTION

LAND CORNER RECORDATION CERTIFICATE

Filing Requirement of Act 74, Mich. P.A. 1970

Located In: Corner Code #

ROBERT F. MIKESCH 11/16/98
HOUGHTON COUNTY, REGISTER 14:44
LC 3/ 541 PAU Fee: 9.00
Page 1 of 1

Register of Deeds Stamp & File Number

1. Public Land Survey	12	T 53W	R 33W	L-3 (L-5)
		T ___	R ___	
		T ___	R ___	
		T ___	R ___	
2. Property Controlling	S ___	T ___	R ___	
in Section	S ___	T ___	R ___	
3. Miscellaneous	S ___	T ___	R ___	
Property in Section	S ___	T ___	R ___	

4. Lot No. _____, Recorded Plat _____
5. Private Claims _____

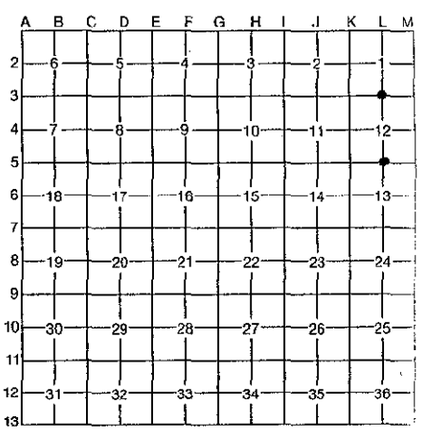

I, *R. W. CRAMPTON*, in a field survey on *OCTOBER 14*, 19 *98*, do hereby certify that under requirements of P.A. 74, Michigan P.A. of 1970, the corner points mentioned in lines 1 and 2 above were in conformance with regulations and rules therefore as required in the current manual of survey instructions of the United States Department of the Interior, Bureau of Land Management or by a decree of a Court of Law and/or that the corner points mentioned in lines 3, 4 and 5 above were in conformance with the rules of the Michigan Board of Professional Surveyors or by a Decree of a Court of Law; established, re-established, monumented, re-monumented, recovered, found as expressed below:

NOTE: Not more than 4 corners, all in the same town and range, may be recorded on this certificate.

A. Description of original monument and accessories and/or subsequent restoration:

L-3, 1/4 CORNER, SECTION 1 & 12
SUGAR FOR QUARTER SECTION CORNER, SUGAR 14, N69W 18.

L-5, 1/4 CORNER SECTIONS 12 & 13
SET QUARTER SECTION POST, SPRUCE 8, N76E 16, Y. BIRCH 14, S56W 16.

B. Description of corner evidence found and/or method applied in restoring or reestablishing corner:

L-3 FOUND 1 1/4" IRON PIPE, 2 1/2' ABOVE GROUND AT INTERSECTION OF FENCES SOUTH, EAST AND WEST OF CORNER.

L-5, FOUND 1 " IRON BOLT IN NORTH-SOUTH FENCE LINE FROM BILLY BUCKLER, DNR LAND CORNER RECORDS DATED 3/24/1966.

STATE of MICHIGAN
ROBERT W. CRAMPTON
LAND SURVEYOR
NO. 24591
PROFESSIONAL SURVEYOR

C. Description of monument for corner and accessories established to perpetuate locating the position of the corner:

L-3 CUT OFF 1 1/4" IRON PIPE AND SET 2 1/4" BRASS CAP. WITNESSED WITH SURVEY TAG NAILED TO: 20" MAPLE TREE N57°W 29.63', 12" ASPEN TREE N20°E 17.04', 14" ASPEN TREE S40°E 12.70', 12" ASPEN TREE S43°W 23.60'.

L-5 REPLACE 1" IRON BOLT WITH 1 1/4" IRON PIPE WITH 2 1/4" BRASS CAP, WITNESSED WITH SURVEY TAG NAILED TO: 14" CEDAR TREE N60°W 30.45', 12" Y. BIRCH TREE N44°E 13.15', 10" CEDAR TREE S71°E 27.02', 14" CEDAR TREE S80°W 17.10', EAST 27.00' TO 1 1/4" IRON PIPE.

Signed by Robert W. Crampton Date Nov. 4, 1998

Surveyor's Michigan License No. 24591

FORM APPROVED BY MICHIGAN STATE BOARD OF PROFESSIONAL SURVEYORS, JAN. 26, 1971
REVISED MAY 14, 1975
REVISED JAN., 1983