

LAND CORNER RECORDATION CERTIFICATE

Filing Requirement of Act 74, Mich. P.A. 1970

REMONUMENTATION

DEC 14 1998

For corners in
HOUGHTON
(County)

Located In:

Corner Code #

- 1. Public Land Survey 13 T 53W R 33W
 18 T 53W R 33W
 T R
 T R
- 2. Property Controlling S T R
 in Section S T R
- 3. Miscellaneous S T R
 Property in Section S T R

M-6, M-7
A-6, A-7

ROBERT F. MIKESCH 11/16/98
HOUGHTON COUNTY, REGISTER 14:47
LC 3/ 551 PAU Fee: 9.00

Page 1 of 1

e Number

- 4. Lot No. _____, Recorded Plat _____
- 5. Private Claims _____

A	B	C	D	E	F	G	H	I	J	K	L	M
2	6	5	4	3	2	1						
3												
4	7	8	9	10	11	12						
5												
6	18	17	16	15	14	13						
7												
8	19	20	21	22	23	24						
9												
10	30	29	28	27	26	25						
11												
12	31	32	33	34	35	36						
13												

I, R. W. CRAMPTON, in a field survey on DECEMBER 23, 1997, do hereby certify that under requirements of P.A. 74, Michigan P.A. of 1970, the corner points mentioned in lines 1 and 2 above were in conformance with regulations and rules therefore as required in the current manual of survey instructions of the United States Department of the Interior, Bureau of Land Management or by a decree of a Court of Law and/or that the corner points mentioned in lines 3, 4 and 5 above were in conformance with the rules of the Michigan Board of Professional Surveyors or by a Decree of a Court of Law; established, re-established, monumented, re-monumented, recovered, found as expressed below:


NOTE: Not more than 4 corners, all in the same town and range, may be recorded on this certificate.

A. Description of original monument and accessories and/or subsequent restoration:

- A-6 & M-6, SET QUARTER POST MAPLE 6, N70E, 9, CEDAR 8, N41W, 4, NS1W 20, Y. BIRCH TREE 10, S60W 14.*
- A-7 & M-7, FIR 6 CORNER OF SECTIONS 13 & 24, HEMLOCK 16, N29E, 28.*

B. Description of corner evidence found and/or method applied in restoring or reestablishing corner:

- A-6 & M-6, SQUARE HEADED BOLT, FOUND, WHICH AGREES WITH THE UNRECORDED PLAT OF PORTAGE VIEW LOTS.*
- A-7 & M-7, 3/4" IRON PIPE FOUND IN CENTERLINE OF COUNTY ROAD T-29 AND 4' EAST OF THE CENTERLINE OF COUNTY ROAD T-641 AND ON PROJECTION OF OLD FENCE, SOUTH OF CORNER.*

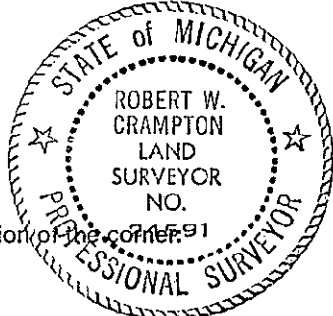

C. Description of monument for corner and accessories established to perpetuate locating the position of the corner:

- A-6 & M-6 SQUARE HEADED BOLT REPLACE WITH 1" IRON PIPE WITH 2 1/4" BRASS CAP. WITNESSED WITH SURVEY TAG NAILED TO: 17" HEMLOCK TREE S82°E 53.98', 5" W. BIRCH TREE S50°E 59.73', 14" BALSAM TREE S77°W 36.54', 24" SPRUCE TREE N19°W 46.64'.*
- A-7 & M-7 3/4" IRON PIPE REPLACED WITH 1" IRON PIPE WITH 2 1/4" BRASS CAP WITNESSED WITH SURVEY TAG NAILED TO: UTILITY POLE N60°W 43.14', UTILITY POLE S60°W 42.04', 12" BALSAM TREE SOUTH 65.87', 6" SPRUCE TREE S70°E 110.77'.*

Signed by Robert W. Crampton Date Nov. 4, 1998
Surveyor's Michigan License No. 24591