

April 30, 1999
Robert W. Crampton

LAND CORNER RECORDATION CERTIFICATE
Filing Requirement of Act 74, Mich. P.A. 1970

SURVEY &
REMONUMENTATION

SEP 17 1999

For corners in
HOUGHTON
(County)

Located In:

Corner Code #

SECTION

1. Public Land Survey	13 T 53N R33W	M-6, M-7 A-6, A-7	Seg. 2
	18 T 53N R32W		
	T _____ R _____		
	T _____ R _____		
2. Property Controlling in Section	S _____ T _____ R _____		
	S _____ T _____ R _____		
3. Miscellaneous Property in Section	S _____ T _____ R _____		
	S _____ T _____ R _____		

MARY SCHOOS 05/04/99 2
HOUGHTON COUNTY, REGISTER 11:08
LC 3/ 588 PAU Fees: 9.00
Page 1 of 1

Register of Deeds Stamp & File Number

4. Lot No. _____, Recorded Plat _____
5. Private Claims _____

I, R.W. CRAMPTON, in a field survey on DECEMBER 23, 19 97, do hereby certify that under requirements of P.A. 74, Michigan P.A. of 1970, the corner points mentioned in lines 1 and 2 above were in conformance with regulations and rules therefore as required in the current manual of survey instructions of the United States Department of the Interior, Bureau of Land Management or by a decree of a Court of Law and/or that the corner points mentioned in lines 3, 4 and 5 above were in conformance with the rules of the Michigan Board of Professional Surveyors or by a Decree of a Court of Law; established, re-established, monumented, re-monumented, recovered, found as expressed below:


NOTE: Not more than 4 corners, all in the same town and range, may be recorded on this certificate.

A. Description of original monument and accessories and/or subsequent restoration:

A-6 & M-6, SET QUARTER POST MAPLE 6, N70E, 9, CEDAR 8, N41W, 4, N51W 20, Y. BIRCH TREE 10, S60W 14.

A-7 & M-7, FIR 6 CORNER OF SECTIONS 13 & 24, HEMLOCK 16, N29E, 28.

A	B	C	D	E	F	G	H	I	J	K	L	M
2	6	5	4	3	2	1						
3												
4	7	8	9	10	11	12						
5												
6	18	17	16	15	14	13						
7												
8	19	20	21	22	23	24						
9												
10	30	29	28	27	26	25						
11												
12	31	32	33	34	35	36						
13												

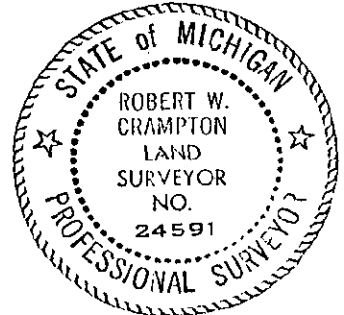

B. Description of corner evidence found and/or method applied in restoring or reestablishing corner:

A-6 & M-6, SQUARE HEADED BOLT, FOUND, WHICH AGREES WITH THE UNRECORDED PLAT OF PORTAGE VIEW LOTS.

A-7 & M-7, 3/4" IRON PIPE FOUND IN CENTERLINE OF COUNTY ROAD T-29 AND 4' EAST OF THE CENTERLINE OF COUNTY ROAD T-641 AND ON PROJECTION OF OLD FENCE, SOUTH OF CORNER.

C. Description of monument for corner and accessories established to perpetuate locating the position of the corner:

A-6 & M-6 SQUARE HEADED BOLT REPLACE WITH 1" IRON PIPE WITH 2 1/4" BRASS CAP. WITNESSED WITH SURVEY TAG NAILED TO: 17" HEMLOCK TREE S82°E 53.98', 5" W. BIRCH TREE S50°E 59.73', 14" BALSAM TREE S77°W 36.54', 24" SPRUCE TREE N19°W 46.64'.

A-7 & M-7 3/4" IRON PIPE REPLACED WITH 1" IRON PIPE WITH 2 1/4" BRASS CAP WITNESSED WITH SURVEY TAG NAILED TO: UTILITY POLE N60°W 43.14', UTILITY POLE S60°W 42.04', 12" BALSAM TREE SOUTH 65.87', 6" SPRUCE TREE S70°E 110.77'.

Signed by Robert W. Crampton

Date MARCH 22, 1999

Surveyor's Michigan License No. 24591