

SEP 17 1999

APR 30, 1999  
 Robert W. Crampton

LAND CORNER RECORDATION CERTIFICATE  
 Filing Requirement of Act 74, Mich. P.A. 1970

For corners in  
HOUGHTON  
 (County)

Located In:

Corner Code #

SECTION

- |                                      |    |       |            |       |            |       |                         |
|--------------------------------------|----|-------|------------|-------|------------|-------|-------------------------|
| 1. Public Land Survey                | 12 | T     | <u>53N</u> | R     | <u>33W</u> | 1/4   | <u>L-3</u> <u>(L-5)</u> |
|                                      |    | T     | _____      | R     | _____      |       | _____                   |
|                                      |    | T     | _____      | R     | _____      |       | _____                   |
|                                      |    | T     | _____      | R     | _____      |       | _____                   |
| 2. Property Controlling in Section   | S  | _____ | T          | _____ | R          | _____ | _____                   |
|                                      | S  | _____ | T          | _____ | R          | _____ | _____                   |
| 3. Miscellaneous Property in Section | S  | _____ | T          | _____ | R          | _____ | _____                   |
|                                      | S  | _____ | T          | _____ | R          | _____ | _____                   |

Seg. 2

MARY SCHOOS 05/04/99 2  
 HOUGHTON COUNTY, REGISTER 11:04  
 LC 3/ 582 PAU Fee: 9.00  
 Page 1 of 1

Register of Deeds Stamp & File Number

4. Lot No. \_\_\_\_\_, Recorded Plat \_\_\_\_\_  
 5. Private Claims \_\_\_\_\_


A	B	C	D	E	F	G	H	I	J	K	L
2	6		5		4		3		2		1
3											
4	7		8		9		10		11		12
5											
6	18		17		16		15		14		13
7											
8	19		20		21		22		23		24
9											
10	30		29		28		27		26		25
11											
12	31		32		33		34		35		36
13											

I, R.W. CRAMPTON, in a field survey on OCTOBER 14, 1998, do hereby certify that under requirements of P.A. 74, Michigan P.A. of 1970, the corner points mentioned in lines 1 and 2 above were in conformance with regulations and rules therefore as required in the current manual of survey instructions of the United States Department of the Interior, Bureau of Land Management or by a decree of a Court of Law and/or that the corner points mentioned in lines 3, 4 and 5 above were in conformance with the rules of the Michigan Board of Professional Surveyors or by a Decree of a Court of Law; established, re-established, monumented, re-monumented, recovered, found as expressed below:

NOTE: Not more than 4 corners, all in the same town and range, may be recorded on this certificate.

A. Description of original monument and accessories and/or subsequent restoration:

- L-3, 1/4 CORNER, SECTION 1 & 12  
 SUGAR FOR QUARTER SECTION CORNER, SUGAR 14, N69W 18.  
 L-5, 1/4 CORNER SECTIONS 12 & 13  
 SET QUARTER SECTION POST, SPRUCE 8, N76E 16, Y. BIRCH 14, S56W 16.

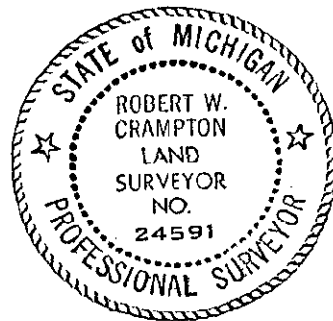

B. Description of corner evidence found and/or method applied in restoring or reestablishing corner:

- L-3 FOUND 1 1/4" IRON PIPE, 2 1/2' ABOVE GROUND AT INTERSECTION OF FENCES SOUTH, EAST AND WEST OF CORNER.  
 L-5, FOUND 1" IRON BOLT IN NORTH-SOUTH FENCE LINE FROM BILLY BUCKLER, DNR LAND CORNER RECORDS DATED 3/24/1966.

C. Description of monument for corner and accessories established to perpetuate locating the position of the corner:

- L-3 CUT OFF 1 1/4" IRON PIPE AND SET 2 1/4" BRASS CAP, WITNESSED WITH SURVEY TAG NAILED TO:  
 20" MAPLE TREE N57°W 29.63', 12" ASPEN TREE N20°E 17.04',  
 14" ASPEN TREE S40°E 12.70', 12" ASPEN TREE S43°W 23.60'.  
 L-5 REPLACE 1" IRON BOLT WITH 1 1/4" IRON PIPE WITH 2 1/4" BRASS CAP, WITNESSED WITH SURVEY TAG NAILED TO:  
 14" CEDAR TREE N60°W 30.45', 12" Y. BIRCH TREE N44°E 13.15',  
 10" CEDAR TREE S71°E 27.02', 14" CEDAR TREE S80°W 17.10', EAST 27.00' TO 1 1/4" IRON PIPE.

Signed by Robert W. Crampton  
 Surveyor's Michigan License No. 24591

Date MARCH 22, 1999