

April 22, 1999
Robert W. Crampton

LAND CORNER RECORDATION CERTIFICATE
Filing Requirement of Act 74, Mich. P.A. 1970

SURVEY &
REMONUMENTATION

SEP 17 1999

For corners in
HOUGHTON
(County)

Located In:

Corner Code #


SECTION

- | | | | | | |
|--------------------------------------|---|------------|---|------------|---|
| 1. Public Land Survey | T | <u>53N</u> | R | <u>33W</u> | |
| | T | <u>53N</u> | R | <u>33W</u> | |
| | T | | R | | |
| | T | | R | | |
| 2. Property Controlling in Section | S | | T | | R |
| | S | | T | | R |
| 3. Miscellaneous Property in Section | S | | T | | R |
| | S | | T | | R |

MEANDER-7 I 2/3 Seg. 2
MEANDER-6 I 2/3

MARY SCHOOS 05/04/99 2
HOUGHTON COUNTY, REGISTER 11:02
LC 3/ 580 PAJ Fee: 9.00
Page 1 of 1

4. Lot No. _____, Recorded Plat _____
5. Private Claims _____

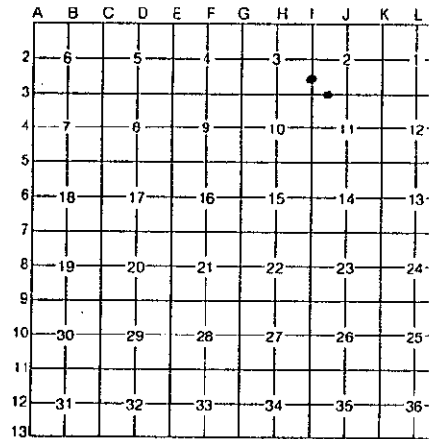

I, R.W. CRAMPTON, in a field survey on OCTOBER 30, 1998, do hereby certify that under requirements of P.A. 74, Michigan P.A. of 1970, the corner points mentioned in lines 1 and 2 above were in conformance with regulations and rules therefore as required in the current manual of survey instructions of the United States Department of the Interior, Bureau of Land Management or by a decree of a Court of Law and/or that the corner points mentioned in lines 3, 4 and 5 above were in conformance with the rules of the Michigan Board of Professional Surveyors or by a Decree of a Court of Law; established, re-established, monumented, re-monumented, recovered, found as expressed below:

NOTE: Not more than 4 corners, all in the same town and range, may be recorded on this certificate.

A. Description of original monument and accessories and/or subsequent restoration:

MEANDER-7, SET MEANDER POST ON LEFT BANK (NO WITNESSES)
MEANDER-6, SET MEANDER POST ON RIGHT BANK, NO TREES FOR BEARING



B. Description of corner evidence found and/or method applied in restoring or reestablishing corner:

MEANDER-7, SET 1 1/4" IRON PIPE WITH 2 1/4" BRASS CAP ON LINE BETWEEN SE CORNER AND SW CORNER OF SECTION 2, 50' FROM THE WATER'S EDGE OF PORTAGE CANAL ON THE WEST BANK. S89°53'44"E 1600.60' FROM SAID SW CORNER.

MEANDER-6, SET 1 1/4" IRON PIPE WITH 2 1/4" BRASS CAP ON LINE BETWEEN NW MEANDER CORNER ON WEST SECTION LINE OF SECTION 2 AND THE SW CORNER OF SECTION 2, 100' FROM WATER'S EDGE OF PORTAGE CANAL ON SOUTH BANK N00°47'36"N 1666.01' FROM SAID SW CORNER.

C. Description of monument for corner and accessories established to perpetuate locating the position of the corner:

MEANDER-7, THE 1 1/4" IRON PIPE WITH BRASS CAP WAS WITNESSED WITH SURVEY TAG NAILED TO: 10" SPRUCE TREE N81°W 133.16', 14" SPRUCE TREE S16°E 193.79', 14" W. BIRCH TREE S28°W 164.82', 14" W. BIRCH TREE S59°W 187.59'.

MEANDER-6, THE 1 1/4" IRON PIPE WITH BRASS CAP WAS WITNESSED WITH SURVEY TAG NAILED TO: 12" W. BIRCH TREE N61°W 19.72', 8" W. BIRCH TREE N02°W 31.46', 12" W. BIRCH TREE S28°W 20.10', 14" W. BIRCH TREE S62°W 22.58'.

Signed by Robert W. Crampton

Date MARCH 22, 1999

Surveyor's Michigan License No. 24591