

LAND CORNER RECORDATION CERTIFICATE
 Filing Requirement of Act 74, Mich. P.A. 1970

SEP 17 1999

For corners in HOUGHTON
 (County)

Located In: Corner Code #

SECTION

1. Public Land Survey T 53N R 33W MEANDER-20
 T 53N R 33W MEANDER-14
 T _____ R _____
 T _____ R _____
2. Property Controlling S _____ T _____ R _____
 in Section S _____ T _____ R _____
3. Miscellaneous S _____ T _____ R _____
 Property in Section S _____ T _____ R _____

MARY SCHOOS 05/04/99 2
 HOUGHTON COUNTY, REGISTER 11:02
 LC 3/ 579 PAJ Fee: 9.00
 Page 1 of 1

4. Lot No. _____, Recorded Plat _____
 5. Private Claims _____


	A	B	C	D	E	F	G	H	I	J	K	L	M
2	6		5		4		3		2		1		
3													
4	7		6		9		10		11		12		
5													
6	18		17		16		15		14		13		
7													
8	19		20		21		22		23		24		
9													
10	30		29		28		27		26		25		
11													
12	31		32		33		34		35		36		
13													

I, R.W. CRAMPTON, in a field survey on OCTOBER 27, 1998, do hereby certify that under requirements of P.A. 74, Michigan P.A. of 1970, the corner points mentioned in lines 1 and 2 above were in conformance with regulations and rules therefore as required in the current manual of survey instructions of the United States Department of the Interior, Bureau of Land Management or by a decree of a Court of Law and/or that the corner points mentioned in lines 3, 4 and 5 above were in conformance with the rules of the Michigan Board of Professional Surveyors or by a Decree of a Court of Law; established, re-established, monumented, re-monumented, recovered, found as expressed below:

NOTE: Not more than 4 corners, all in the same town and range, may be recorded on this certificate.

A. Description of original monument and accessories and/or subsequent restoration:

MEANDER-20, SET MEANDER POST, Y. PINE 7, N65E 61, Y. PINE 12, S17E 26.
 MEANDER-14, SET MEANDER POST, W. PINE 10, N11E 10, W. PINE 6, S40E 09.

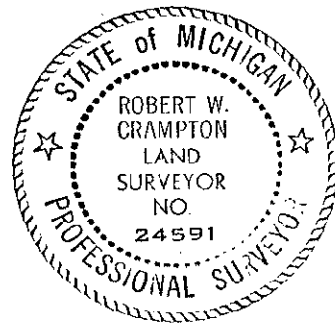

B. Description of corner evidence found and/or method applied in restoring or reestablishing corner:

MEANDER-20, FOUND TWO 3/4" IRON RODS IN CONCRETE (DIST.) 0.56' SOUTH OF LINE BETWEEN THE SE CORNER AND THE THE SW CORNER OF SECTION 13, T53N, R33W.

MEANDER-14, NOTHING FOUND, SET 1 1/4" IRON PIPE WITH 2 1/4" BRASS CAP ON LINE BETWEEN SOUTH 1/4 CORNER AND MEANDER CORNER ON WEST SIDE OF PORTAGE RIVER, SECTION 12, T53N, R33W, ON EAST SIDE OF PORTAGE RIVER 97' FROM WATER'S EDGE.

C. Description of monument for corner and accessories established to perpetuate locating the position of the corner:

MEANDER-20, SET 1 1/4" IRON PIPE WITH 2 1/4" BRASS CAP 0.56' NORTH OF RODS IN CONCRETE, WAS WITNESSED WITH SURVEY TAG NAILED TO: NORTH POST OF THREE POST SIGN (TELEPHONE POLE) S88°W 11.55', UTILITY POLE S01°E 75.81' (PK NAIL FOUND), UTILITY POLE S76°E 161.75', N48°E 26.65' TO CENTER OF 6" PLASTIC STAND PIPE.

MEANDER-14, THE 1 1/4" IRON PIPE WITH BRASS CAP WAS WITNESSED WITH SURVEY TAG NAILED TO: 11" W. BIRCH TREE N64°W 34.95', 12" S. MAPLE TREE N70°E 3.12', 12" SPRUCE TREE S21°E 51.01', 6" W. BIRCH TREE S34°W 21.57'.

Signed by Robert W. Crampton Date MARCH 22, 1999
 Surveyor's Michigan License No. 24591