

LAND CORNER RECORDATION CERTIFICATE

FILING REQUIREMENT OF ACT 74, MICH. P.A.1970

Houghton Co.

FOR CORNERS OF--	LOCATED IN--	CORNER CODE NUMBER
1. PUBLIC LAND SURVEY	T. <u>53N</u> N. S., R. <u>33W</u> E. W.	<u>D10, D9</u>
2. PROPERTY CONTROLLING IN SECTION	<u>29</u> , T. <u>53N</u> N. S., R. <u>33W</u> E. W.	<u>2</u>
3. MISCELLANEOUS PROPERTY IN SECTION	T. _____ N. S., R. _____ E. W.	_____
4. LOT NO. _____, RECORDED PLAT _____		
5. PRIVATE CLAIMS _____		

REGISTER OF DEEDS STAMP AND FILING NUMBER

I, Keith L. Sackett, do hereby certify that under requirements of P.A. 74, Michigan P.A. of 1970, the corner points mentioned in lines 1 and 2 above were, in a field survey on March 8, 1979, established, re-established, monumented, re-monumented, recovered or restored as expressed below and in conformance with regulations and rules therefore as required in the current manual of survey instructions of the United States Department of the Interior, Bureau of Land Management or by a decree of a court of law. Furthermore, that the corner points mentioned in lines 3, 4 and 5 above were, in a field survey on _____, 19____, found, recovered, restored, established or re-established as expressed below and in conformance with the rules of the Michigan State Board of Registration for Land Surveyors or, by a Decree of a Court of law:

A. Description of original monument and accessories and/or subsequent restoration:
Corner D10: Not set on original survey nor subsequently apparently.
Corner D9: Original monument and accessories not found. Found two old wood posts set by unknown person. They are at old fence corner. Fit good with land calls and other corners
Corner 2: Not set on original survey nor subsequently apparently.

B. Description of corner evidence found and/or method applied in restoring or re-establishing corner:
Corner D10: Established during section subdivision.
Corner D9: Restored at old posts.
Corner 2: Established on line and midway between corners.

C. Description of monument for corner and accessories established to perpetuate locating the position of the corner:
Corner D10: Set 1" I.D. by 4 ft. iron pipe.
 9" Tamarack N70°E 15.8 Ft.
 10" Maple S08°W 26.1 Ft.
Corner D9: Set 1" I.D. x 36" iron pipe.
 7" Ash S07°E 29.0 Ft. 1/4 S, NBT
 10" Maple N25°W 10.0 Ft. 1/4 S, NBT
 10" Maple N19°E 53.7 Ft. 1/4 S, NBT
Corner 2: Set 1" I.D. x 36" iron pipe.
 5" Maple S50°W 17.2 Ft. 1/16 S, BT
 3" Maple N36°W 17.9 Ft. 1/16 S, BT
 7" Maple N24°E 3.3 Ft. 1/16 S, BT

SIGNED BY _____ DATE _____


SURVEYOR'S MICHIGAN REGISTRATION NO. _____

(SEAL)

FOR STATE AND UNITED STATES AGENCIES:

SIGNED BY _____ DATE _____

APPROVED AND SIGNED BY Keith L. Sackett DATE 2/6/80
CHIEF OF SURVEY PARTY
MICHIGAN REGISTERED LAND SURVEYOR
 Keith L. Sackett
 Michigan Dept. of Natural Resources

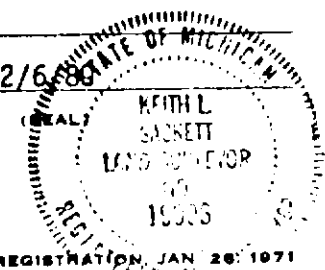

SURVEYOR'S MICHIGAN REGISTRATION NO. 19006