

LAND CORNER RECORDATION CERTIFICATE
Filing Requirement of Act 74, Mich. P.A. 1970

For corners in

Houghton

(County)

Located In:

Corner Code #

1. Public Land Survey

T 53R 34N D3

T 53R 34N 83

T _____ R _____

T _____ R _____

2. Property Controlling
in Section

S _____ T _____ R _____

S _____ T _____ R _____

3. Miscellaneous
Property in Sec.

S _____ T _____ R _____

S _____ T _____ R _____

Register of Deeds Stamp & File Number

4. Lot No. _____, Recorded Plat _____

5. Private Claims _____

Jul 08 2003

I, Stephan J. Szyszkoski, in a field survey on _____, 20____ do hereby state that under requirements of P.A. 74, Michigan P.A. of 1970, the corner points mentioned in lines 1 and 2 above were in conformance with regulations and rules therefore as required in the current manual of survey instructions of the United States Department of the Interior, Bureau of Land Management or by a decree of a Court of Law and/or that the corner points mentioned in lines 3, 4 and 5 above were in conformance with the rules of the Michigan Board of Land Surveyors or by a Decree of a Court of Law; established, re-established, monumented, recovered, found as expressed below:

NOTE: Not more than 2 corners, all in the same town and range, may be recorded on this certificate.

	A	B	C	D	E	F	G	H	I	J	K	L	M
1													
2		6		5		4		3		2		1	
3		7		8		9		10		11		12	
4													
5													
6		18		17		16		15		14		13	
7													
8		19		20		21		22		23		24	
9													
10		30		29		28		27		26		25	
11													
12		31		32		33		34		35		36	
13													

A. Description of original monument and accessories and/or subsequent restoration:

(D3) Quarter corner common to Sections 5 & 8. 1846: Established by Sylvester Higgins: West corrected between Sec. 5 and 8...39.95 Set 1/4 sec. post. Sugar 14 S60W 19, Y. Birch 12 N15E 22...79.90 Sec. cor. Found no other record. Notes of P.A. Larson dated 1919 and 1922 show that Section corners East and West had been monumented by him, but I found no record of this corner.

(83) Quarter corner common to Sections 6 and 7. 1846: Established by Sylvester Higgins: East corrected between Sec. 6 & 7...39.18 Set 1/4 sec. post. Sugar 10 N50W 30, Sugar 8 S70E 12...79.18 Sec. cor. 1922: P.A. Larson found both Sugar 8Ts and set hemlock post and marked Hemlock 12 South 17 feet. No distances east or west noted.

B. Description of corner evidence found and/or method applied in restoring or reestablishing corner:

(D3) The original post and accessories were not recovered. Found a 1" ID iron pipe, projecting 8" above ground. True bearings and distances to adjacent corners were found to be N88-09-23W 2684.67' to a corner reestablished by the undersigned using proportionate measurement, and S87-57-51E 2671.74' to a found 1.5" ID iron pipe. Accepted the monument as the best available evidence of the position of the original corner.

(83) The original post and accessories were not recovered. Larson's post and NBT were not recovered. All above may have been destroyed by road construction as the proportionate position for this corner falls near the SW edge of forest road construction. Reestablished the corner 40 chains west of C3, proportionate to the original record, and on a line of mean true bearing between A3 and C3. Distances East and West to section corners are 2686.76' and 2631.65, respectively.

C. Description of monument for corner and accessories established to perpetuate locating the position of the corner:

(D3) Found 1" ID iron pipe. Blazed, scribed, and set measuring nails in:

7" Sugar N18E 17.3' "1/4S NBT"

5" Sugar N48E 13.7' do

6" Sugar S61E 8.5' do

7" Sugar S86W 19.5' do

Set a sq'd Sugar post adjacent.

Bearings are magnetic. Distances are to nail with tag.

(83) Set 1" ID x 32" I. pipe with 4" alum.

MDNR cap. Blazed, scribed, and set measuring nails in:


9" Sugar N14E 84.4' "1/4S NBT"

5" Sugar S45E 13.4' do

15" Sugar S02W 27.4' do

6" Y. Birch S40W 17.1' do

Set sq'd Sugar post adjacent. Bearings are magnetic. Distances are to nail with tag.

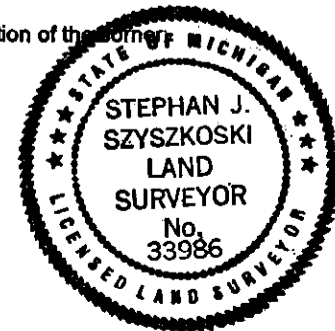

Signed by Stephan J. Szyszkoski

Date 8/11/03

Surveyor's Michigan License No. 33986