

LAND CORNER RECORDATION CERTIFICATE
Filing Requirement of Act 74, Mich. P.A. 1970

For corners in

Houghton

(County)

Located In:

Corner Code #

1. Public Land Survey	T 53N R 34W	84
	T 53N R 34W	A3
	T _____ R _____	_____
	T _____ R _____	_____
2. Property Controlling in Section	S _____ T _____ R _____	_____
	S _____ T _____ R _____	_____
3. Miscellaneous Property in Sec.	S _____ T _____ R _____	_____
	S _____ T _____ R _____	_____

Register of Deeds Stamp & File Number

4. Lot No. _____, Recorded Plat _____
 5. Private Claims _____

Jul 16 2003

I, Stephan J. Szyszkoski, in a field survey on _____, 20____ do hereby state that under requirements of P.A. 74, Michigan P.A. of 1970, the corner points mentioned in lines 1 and 2 above were in conformance with regulations and rules therefore as required in the current manual of survey instructions of the United States Department of the Interior, Bureau of Land Management or by a decree of a Court of Law and /or that the corner points mentioned in lines 3, 4 and 5 above were in conformance with the rules of the Michigan Board of Land Surveyors or by a Decree of a Court of Law; established, re-established, monumented, recovered, found as expressed below:

NOTE: Not more than 2 corners, all in the same town and range, may be recorded on this certificate.

1	A	B	C	D	E	F	G	H	I	J	K	L	M	
2		6		5		4		3		2		1		
3	●													
4	●					8		9		10		11		12
5														
6		18		17		16		15		14		13		
7														
8		19		20		21		22		23		24		
9														
10		30		29		28		27		26		25		
11														
12		31		32		33		34		35		36		
13														

A. Description of original monument and accessories and/or subsequent restoration:

(B4) Center of Section 7. Not established in the original survey.

(A3) Corner common to Sections 6-7 T53N-R34W and 1-12 T53N-R35W. 1845: Established by Wm A. Burt: North on East side Sec. 12...80.00 Set post cor. of sec. 1 & 12. Sugar 14 S23E 65, Sugar 10 N25W 8.

B. Description of corner evidence found and/or method applied in restoring or reestablishing corner:


(B4) Established the corner at the intersection of straight lines connecting opposite Quarter corners.

(A3) The original post and accessories were not recovered. Found a 1" iron pipe, projecting about 12" above ground, with four nearby trees having measuring nails and overgrown blazes facing the pipe, witnesses of an unknown surveyor. True bearing and distance to original corner A5 was found to be S 00 deg. 1'27"E 5282.98' and to probable original corner A4 S 00 deg. 3'28"W 2659.06' (true bearings). North of this corner, at A1, I found 2 iron pipes separated by a distance of 14.55'. The bearing and distance to the NE'y of these two pipes, N 00 deg. 5'04"W 5259.63', conforms very well to the GLO record (North, 5261.5'). I accepted the pipe at A3 as the best available evidence of the position of the original corner. Three of the existing witness trees were cut down to facilitate GPS observations. The fourth, a 12" Sugar N82E was re-marked and is described below.

C. Description of monument for corner and accessories established to perpetuate locating the position of the corner:

(B4) Set 1"IDx32" I.pipe with 4" alum. MDNR cap. Blazed, scribed, and set measuring nails in:
 12" Y.Birch N12W 10.5' "C1/4 BT"
 11" Sugar N30E 14.3' do
 8" Sugar N87E 33.6' do
 14" Sugar S64E 30.2' do
 Set sq'd Sugar post 2.5' S'y. Bearings are magnetic. Distances are to nail with tag.

(A3) Found 1" Iron pipe. Placed plastic cap #33986 in the pipe. Blazed, scribed and set measuring nails in:
 12" Sugar N82E 21.5' fd. nail "S6 NBT"
 10" Sugar S19W 36.2' "S12 NBT"
 9" Sugar S72W 29.5' do
 6" Sugar N58W 20.1' "S1 NBT"
 Placed sq'd Sugar post adjacent. Bearings are magnetic. Distances are to nail with tag.

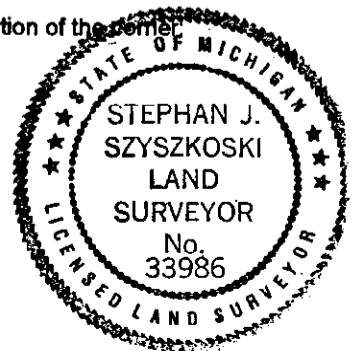

Signed by Stephan J. Szyszkoski
 Surveyor's Michigan License No. 33986

Date 7/23/03