

LAND CORNER RECORDATION CERTIFICATE
Filing Requirement of Act 74, Mich. P.A. 1970 as Amended

For corners in

Houghton	Located In:	Corner Code #
(County)		
1. Public Land Survey	T _____ R _____	_____
	T _____ R _____	_____
	T _____ R _____	_____
2. Property Controlling in Section	S 17 T 53N R 34W	16
	S 17 T 53N R 34W	13
	S _____ T _____ R _____	_____
3. Miscellaneous Property in Sec.	S _____ T _____ R _____	_____
	S _____ T _____ R _____	_____
4. Lot No. _____, Recorded Plat _____		
5. Private Claims _____		

Register of Deeds Stamp & File Number

	A	B	C	D	E	F	G	H	I	J	K	L	M
1													
2	6			5			4			3			2
3													
4	7			8			9			10			11
5													
6	18			17			16			15			14
7													
8	19			20			21			22			23
9													
10	30			29			28			27			26
11													
12	31			32			33			34			35
13													

I, Stephan J. Szyszkoski, in a field survey on 08/19/2010 do hereby state that under requirements of P.A. 74, Michigan P.A. of 1970, the corner points mentioned in lines 1 and 2 above were in conformance with regulations and rules therefore as required in the current manual of survey instructions of the United States Department of the Interior, Bureau of Land Management or by a decree of a Court of Law and /or that the corner points mentioned in lines 3, 4 and 5 above were in conformance with the rules of the Michigan Board of Land Surveyors or by a Decree of a Court of Law; established, re-established, monumented, recovered, found as expressed below:

NOTE: Not more than 2 corners, all in the same town and range, may be recorded on this certificate.

A. Description of original monument and accessories and/or subsequent restoration:

(16-Sec. 17) East 1/16 corner between Sections 17 and 20. Not established in the original survey.

(13-Sec. 17) Southeast 1/16 corner, Section 17. Not established in the original survey.

B. Description of corner evidence found and/or method applied in restoring or reestablishing corner:

(16-Sec. 17) Established the corner midway and on the Section line between Section corner 1334.25' east and Quarter corner 1334.25' west.

(13-Sec. 17) Established the corner at the intersection of straight lines connecting opposite 1/16 corners.


C. Description of monument for corner and accessories established to perpetuate locating the position of the corner:

(16) Set 1"IDx32" I.pipe with 4" alum. MDNR cap. Set measuring nail with MDNR tag in the side of:
 6" Maple N54E 14.45' mrkd "1/16S BT"
 5" Sugar S61E 19.35' do
 5" Sugar S54W 2.9' do
 7" Maple N24W 21.75' do
 Set sq'd cedar post adjacent.
 Bearings are magnetic.

(13) Set 1"IDx32" I.pipe with 4" alum. MDNR cap. Set measuring nail with MDNR tag in the side of:
 4" Cherry N59E 5.2' mrkd "1/16S BT"
 4" twin Maple S82E 13.3' do
 Spruce S29W 7.15' do
 twin 3" Maple N35W 2.55' do
 Set sq'd cedar post adjacent.
 Bearings are magnetic.

Signed by *Stephan J. Szyszkoski*
 Surveyor's Michigan License No. 33986

Date 08/31/2010

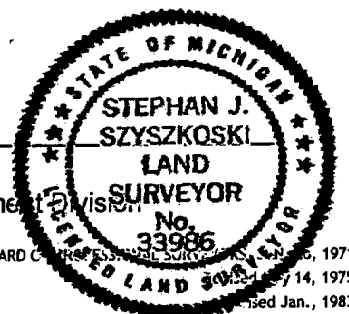

For the Michigan Department of Natural Resources and Environment, Forest Management Division