

JUL 28 1999

APR 30 1999  
*Ronald S. Haataja*

LAND CORNER RECORDATION CERTIFICATE  
Filing Requirement of Act 74, Mich. P.A. 1970

SECTION

For corners in Houghton Located In: \_\_\_\_\_ Corner Code # \_\_\_\_\_  
(County)

1. Public Land Survey	T	<u>54N</u>	R	<u>32W</u>	<u>A-6, A-7</u>
	T	_____	R	_____	_____
	T	_____	R	_____	_____
	T	_____	R	_____	_____
2. Property Controlling in Section	S	_____	T	_____	_____
	S	_____	T	_____	_____
3. Miscellaneous Property in Section	S	_____	T	_____	_____
	S	_____	T	_____	_____

MARY SCHOOS 05/05/99 2  
HOUGHTON COUNTY, REGISTER 15:08  
LC 3/ 598 PAJ Fee: 9.00  
Page 1 of 1

Register of Deeds Stamp & File Number

4. Lot No. \_\_\_\_\_, Recorded Plat \_\_\_\_\_  
5. Private Claims \_\_\_\_\_

A	B	C	D	E	F	G	H	I	J	K	L	M
2	6	5	4	3	2	1						
3												
4	7	8	9	10	11	12						
5												
6	18	17	16	15	14	13						
7												
8	19	20	21	22	23	24						
9												
10	30	29	28	27	26	25						
11												
12	31	32	33	34	35	36						
13												

Ronald S. Haataja in a field survey on August 17, 1998, do hereby certify that under requirements of P.A. 74, Michigan P.A. of 1970, the corner points mentioned in lines 1 and 2 above were in conformance with regulations and rules therefore as required in the current manual of survey instructions of the United States Department of the Interior, Bureau of Land Management or by a decree of a Court of Law and/or that the corner points mentioned in lines 3, 4 and 5 above were in conformance with the rules of the Michigan Board of Professional Surveyors or by a Decree of a Court of Law; established, re-established, monumented, re-monumented, recovered, found as expressed below:

NOTE: Not more than 4 corners, all in the same town and range, may be recorded on this certificate.

A. Description of original monument and accessories and/or subsequent restoration:

(A-6) W1/4 Corner Section 18, T54N-R32W  
40.00 Set Quarter Section Post.  
Witnesses: Fir 6" N45W 15 lks.  
Do 8" S79E 5 lks.

(A-7) SW Corner Section 18, T54N-R32W  
80.00 W. Pine 10" Corner of Sections 13 & 24, (T54N-R32W)  
Witnesses: Fir 12" N22E 28 lks.

B. Description of corner evidence found and/or method applied in restoring or reestablishing corner:


(A-6) W1/4 Corner Section 18, T54N-R32W  
Found 2" O.D. Pipe 16" above ground

(A-7) SW Corner Section 18, T54N-R32W  
Found 1-1/2" pipe loose in rotting pine stump, tightened by driving 1/2" pin through stump and cemented pipe onto pin. Found near a Quincy Mining Company corner tag in tree.

C. Description of monument for corner and accessories established to perpetuate locating the position of the corner:

(A-6) W1/4 Corner Section 18, T54N-R32W  
Stamped and cemented brass remon cap into pipe.  
Witnesses: Brass tags PS #38478 nailed to side of trees.  
12" Soft Maple S78°E 26.97', 5" Sugar Maple N08°W 11.50',  
24" Oak S70°W 8.39', 6" Yellow Birch S2°W 5.60', 3/4" sq. pin S13°E 8.46'

(A-7) SW Corner Section 18, T54N-R32W  
Stamped and cemented a brass remon. cap onto the 1-1/2" pipe  
Witnesses: Brass tags PS#39478 nailed to side of trees  
6" Maple w/Q.M.C. tag S52°W 22.19', 5" Maple N67°W 18.54',  
8" Yellow Birch N08°E 9.18', 3" Balsam S58°E 14.84'.

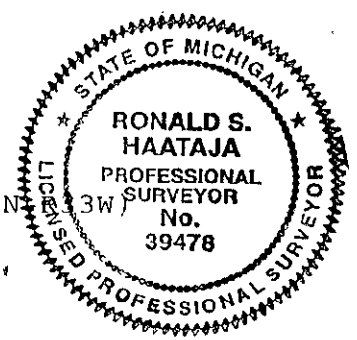

Signed by Ronald S. Haataja Date April 6, 1999  
Surveyor's Michigan License No. 39478