SURVEY &
REMONUMENTATION

JUL 2 8 1999

SECTION

APPROVED LAND CORNER
P.A. 345 of 1990
Houghton County
April 20, 1999
Robert W. Crampt

LAND CORNER RECORDATION CERTIFICATE
Filing Requirement of Act 74,
Mich. P.A. 1970

MARY SCHOOS 05/05/99 2
HOUGHTON COUNTY, REGISTER 15:07
LC 3/ 594 PAU Fee: 9.00
Page 1 of 1

For corners in

Houghton County (County) Located In: Corner Code #

1. Public Land Survey Section 32		T 55N	R 32W	C-13 (SW Corner Section 32)
		T____	R____	
	Section 5	T 54N	R 32W	C-1 (NW Corner Section 5)
		T____	R____	
2. Property Controlling	S____	T____	R____	
in Section	S____	T____	R____	
3. Miscellaneous	S____	T____	R____	
Property in Sec.	S____	T____	R____	

Register of Deeds Stamp & File Number

4. Lot No. _____ , Recorded Plat _____
5. Private Claims _____

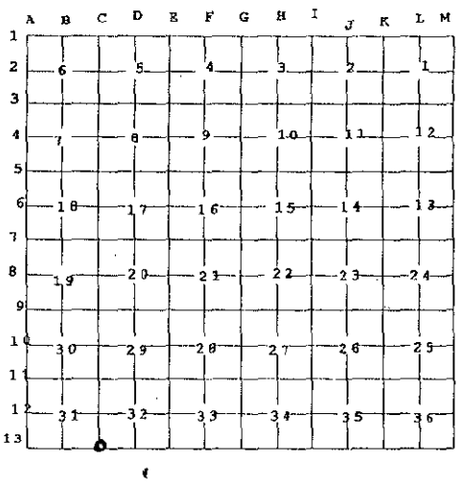

I, Michael T. Drewyor, in a field survey on December 4, 19 97 do hereby state that under requirements of P.A. 74, Michigan P.A. of 1970, the corner points mentioned in lines 1 and 2 above were in conformance with regulations and rules therefore as required in the current manual of survey instructions of the United States Department of the Interior, Bureau of Land Management or by a decree of a Court of Law and /or that the corner points mentioned in lines 3, 4 and 5 above were in conformance with the rules of the Michigan Board of Land Surveyors or by a Decree of a Court of Law; established, re-established, monumented, recovered, found as expressed below:

NOTE: Not more than 2 corners, all in the same town and range, may be recorded on this certificate.

A. Description of original monument and accessories and/or subsequent restoration:

SE ¼-Corner, Section 31: At 79.00 chains (meas. from W) set section post corner of Sections 31 & 32.

White Pine 10, N 38° W, 04
Fir 8, N 62° E, 07

No evidence of original monument or accessories found. This line was originally surveyed by Deputy Surveyor William Ives between July 13, 1845 & July 24, 1845.

B. Description of corner evidence found and/or method applied in restoring or reestablishing corner:

Found 1" solid iron rod 5" above grade 5' south of the southerly edge of gravel driveway. This corner is located in the yard at Fire No. 139 on Bootjack Road.

C. Description of monument for corner and accessories established to perpetuate locating the position of the corner:

All witness points in trees are PK nails and washers.

SW Corner of Section – Found 1" ID iron pipe (description above).

Witnesses:

N 10° E,	22.21 ft.,	Power Pole
N 63° E,	1.76 ft.,	22" Pine
S 04° E,	21.22 ft.,	15" Pine
N 74° W,	6.43 ft.,	20" White Birch

Signed by Michael T. Drewyor Date April 13, 1999
Surveyor's Michigan License No. 24245

FORM APPROVED BY MICHIGAN STATE BOARD OF PROFESSIONAL SURVEYORS, JAN. 28, 1971

REVISED MAY 14, 1975
REVISED JAN., 1983
REVISED OCT., 1995

By: Hitch, Inc., P.C., Houghton, MI
Job #97012