

April 30, 1999
Robert W. Camp

SURVEY & REMONUMENTATION

SEP 17 1999

LAND CORNER RECORDATION CERTIFICATE
Filing Requirement of Act 74, Mich. P.A. 1970

For corners in

Houghton Located In: 34 Corner Code #
(County)

SECTION

- 1. Public Land Survey T 54N R 33W I-13
T 54N R 33W I-12
T R
T R
T R
- 2. Property Controlling In Section S T R
S T R
S T R
- 3. Miscellaneous Property in Sec. S T R
S T R

MARY SCHOOS 05/19/99 2
HOUGHTON COUNTY, REGISTER 13:53
LC 3/ 600 PAU Fee: 9.00
Page 1 of 1

Register of Deeds Stamp & File Number

- 4. Lot No. , Recorded Plat
- 5. Private Claims

I, Robert A. Goodreau in a field survey on September, 1998 do hereby state that under requirements of P.A. 74, Michigan P.A. of 1970, the corner points mentioned in lines 1 and 2 above were in conformance with regulations and rules therefore as required in the current manual of survey instructions of the United States Department of the Interior, Bureau of Land Management or by a decree of a Court of Law and/or that the corner points mentioned in lines 3, 4 and 5 above were in conformance with the rules of the Michigan Board of Land Surveyors or by a Decree of a Court of Law; established, re-established, monumented, recovered, found as expressed below:

	A	B	C	D	E	F	G	H	I	J	K	L	M
1													
2	6		5			4		3		2		1	
3													
4	7		8			9		10		11		12	
5													
6	18		17			16		15		14		13	
7													
8	19		20			21		22		23		24	
9													
10	30		29			28		27		26		25	
11													
12	31		32			33		34		35		36	
13													

NOTE: Not more than 2 corners, all in the same town and range, may be recorded on this certificate.

- A. Description of original monument and accessories and/or subsequent restoration:
I-12 Wood Post - 1845 by D. Houghton.
Hemlock, 14", N18°E, 9 LKS
Yellow Birch, 8", S38°W, 7 LKS

- I-13 Wood Post
Fir, 8", N35°W, 33 LKS
Yellow Birch, 10", N13°E, 13 LKS

Per Land Corner Recordation Certificate by John I. Haataja: Vol. 1, Page 161
According to local resident an iron pipe in center of road was marking this corner at one time.
Nail in road established by John I. Haataja.


No original evidence found.

- B. Description of corner evidence found and/or method applied in restoring or reestablishing corner:
I-12 Found 1 1/2" I.D. Pipe. Accepted corner as found.
I-13 Found 1 1/2" square pin centerline intersection of 2 track and Co. Rd. T-641.
Found Brass Tag #19833 and nail in utility pole N64°E 63.80'. Accepted corner as found.

- C. Description of monument for corner and accessories established to perpetuate locating the position of the corner:
(I-12) Set 2" Brass remon cap on top of found pipe. Set witness with 60d nail, brass "UPEA" tag, chest blaze.
Sugar Maple, 10", SCR. NBT, N14°E, 6.30'
Red Maple, 10", SCR. NBT, S51°E, 26.31'
Sugar Maple, 8", SCR. NBT, N36°W, 26.35'
Sugar Maple, 12", SCR NBT, S86°W, 8.31'
(I-13) Set 2" Brass remon cap on top of found square pin. Set witness with 60d nail, brass "UPEA" tag, chest blaze.
Oak, 9", SCR NBT, N33°W, 59.85'
Oak, 6", SCR NBT, S33°W, 35.94'
White Birch, SCR NBT, S44°E, 48.61'

Signed by RAV
Surveyor's Michigan License No. 43053

Date 3-30-99

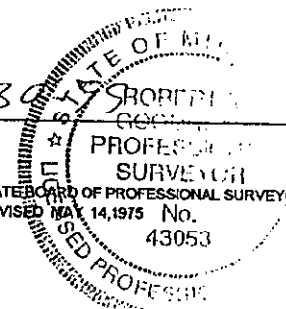

FORM APPROVED BY MICHIGAN STATE BOARD OF PROFESSIONAL SURVEYORS, JAN. 28, 1971
REVISED MAY 14, 1975 No. 43053

REVISED JAN., 1983
REVISED OCT., 1995