

DEC 14 1998

**LAND CORNER RECORDATION CERTIFICATE**  
Filing Requirement of Act 74, Mich. P.A. 1970

SECTION

Nov. 6, 1998  
*Ronald W. Crampton*

For corners in  
Houghton  
(County)

Located In: Corner Code #

ROBERT F. MIKESCH 11/11/98  
HOUGHTON COUNTY, REGISTER 09:39  
3/ 515 PAU Fee: 9.00  
Page 1 of 1

- |                                      |                           |               |
|--------------------------------------|---------------------------|---------------|
| 1. Public Land Survey                | T <u>54N</u> R <u>33W</u> | <u>K-6</u>    |
|                                      | T <u>54N</u> R <u>33W</u> | <u>Z13</u> LC |
|                                      | T _____ R _____           | _____         |
|                                      | T _____ R _____           | _____         |
| 2. Property Controlling in Section   | S _____ T _____ R _____   | _____         |
|                                      | S _____ T _____ R _____   | _____         |
| 3. Miscellaneous Property in Section | S _____ T _____ R _____   | _____         |
|                                      | S _____ T _____ R _____   | _____         |

Register of Deeds Stamp & File Number

4. Lot No. \_\_\_\_\_, Recorded Plat \_\_\_\_\_  
5. Private Claims \_\_\_\_\_

	A	B	C	D	E	F	G	H	I	J	K
2	6		5		4		3		2		
3											
4	7		8		0		10		11		
5											
6	18		17		16		15		14		
7											
8	19		20		21		22		23		
9											
10	30		29		28		27		26		
11											
12	31		32		33		34		35		
13											

I, Ronald S. Haataja, in a field survey on April, 1998, do hereby certify that under requirements of P.A. 74, Michigan P.A. of 1970, the corner points mentioned in lines 1 and 2 above were in conformance with regulations and rules therefore as required in the current manual of survey instructions of the United States Department of the Interior, Bureau of Land Management or by a decree of a Court of Law and/or that the corner points mentioned in lines 3, 4 and 5 above were in conformance with the rules of the Michigan Board of Professional Surveyors or by a Decree of a Court of Law; established, re-established, monumented, re-monumented, recovered, found as expressed below:

NOTE: Not more than 4 corners, all in the same town and range, may be recorded on this certificate.

A. Description of original monument and accessories and/or subsequent restoration:


(K-6) W 1/4 Corner Section 13, T54N-R33W  
40.00 Set Quarter Section post  
Witnesses: Cedar 5" N37°W 5 lks.  
Fir 10" S35°E 15 lks.

(Z13) Meander Corner between Sections 13 & 14, T54N-R33W  
56.40 Intersected Portage Lake, Set Meander Corner  
Witnesses: White Birch 6" S24°E 28 lks.  
Aspen 9" S14°W 25 lks.

B. Description of corner evidence found and/or method applied in restoring or reestablishing corner:

(K-6) W 1/4 Corner Section 13, T54N-R33W  
Found 5/8" Iron Pin in East shoulder of Johnson Road (15'± East of centerline) according to survey by R.W.Crampton dated April 13, 1990.

(Z13) Meander Corner between Sections 13 & 14, T54N-R33W  
Found 3/4" Iron pin as shown on a survey by J.I.Haataja dated August 5, 1978. Found 16' from water's edge.

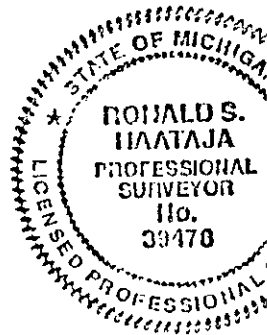

C. Description of monument for corner and accessories established to perpetuate locating the position of the corner:

(K-6) W 1/4 Corner Section 13, T54N-R33W  
Drove 1 1/2" pipe over 5/8" pin and stamped and cemented a brass remon. cap into pipe. Witnesses: brass tags PS#39478 nailed into side of trees: 8" W.Birch N75°E 9.56', Util. Pole S31°W 93.37', 3" Oak N78°W 51.39', PK nail in S.end Conc. Headwall (East side rd) N14°E 38.49', PK in S.end Headwall (West side rd) N38°W 64.08'

(Z13) Meander Corner between Sections 13 & 14, T54N-R33W  
Drove 2" Alum pipe over 3/4" pin and stamped and cemented a brass remon cap to pipe. Witnesses: Brass tags PS#39478 nailed into side of trees: 8" Balsam N36°W 4.90', 24" Spruce N85°E 21.65', 14" W.Birch S3°E 41.65', 14" W.Birch S63°W 33.75'.

Signed by Ronald S. Haataja Date November 6, 1998

Surveyor's Michigan License No. 39478