

LAND CORNER RECORDATION CERTIFICATE  
 Filing Requirement of Act 74, Mich. P.A. 1970

SURVEY & REMONUMENTATION

SEP 17 1999

APRIL 30, 1999  
 Robert W. Camp

For corners in

Houghton Located In: 35 Corner Code #  
 (County)

1. Public Land Survey T 54N R 33W K-12  
 T R  
 T R  
 T R  
 T R

2. Property Controlling S T R  
 in Section S T R  
 3. Miscellaneous S T R  
 Property in Sec. S T R

MARY SCHOOS 05/19/99 2  
 HOUGHTON COUNTY, REGISTER 13:55  
 LC 3/ 607 PAU Fee: 9.00  
 Page 1 of 1

SECTION

Register of Deeds Stamp & File Number

4. Lot No. \_\_\_\_\_, Recorded Plat \_\_\_\_\_  
 5. Private Claims \_\_\_\_\_

I, Robert A. Goodreau in a field survey on September, 19 98 do hereby state that under requirements of P.A. 74, Michigan P.A. of 1970, the corner points mentioned in lines 1 and 2 above were in conformance with regulations and rules therefore as required in the current manual of survey instructions of the United States Department of the Interior, Bureau of Land Management or by a decree of a Court of Law and/or that the corner points mentioned in lines 3, 4 and 5 above were in conformance with the rules of the Michigan Board of Land Surveyors or by a Decree of a Court of Law, established, re-established, monumented, recovered, found as expressed below:

NOTE: Not more than 2 corners, all in the same town and range, may be recorded on this certificate.


	A	B	C	D	E	F	G	H	I	J	K	L	M
1													
2		6		5		4		3		2		1	
3													
4		7		8		9		10		11		12	
5													
6		18		17		16		15		14		13	
7													
8		19		20		21		22		23		24	
9													
10		30		29		28		27		26		25	
11													
12		31		32		33		34		35		36	
13													

A. Description of original monument and accessories and/or subsequent restoration:  
 K-12 Post Set - 1845 by D. Houghton.  
 Maple, 14" S68°W, 17 LKS  
 Yellow Birch, 5" N49°E, 12 LKS

No original evidence found.

B. Description of corner evidence found and/or method applied in restoring or reestablishing corner:  
 K-12 Found 1 1/4" I.D. Pipe 1.3' above ground. Marked by Vulcan Corp. bearing tag in tree.  
 Accepted corner as found.

C. Description of monument for corner and accessories established to perpetuate locating the position of the corner:  
 K-12 Set 2" Brass remon cap on top of found pipe. Witness set with 60d nail, brass "UPEA" facing west blaze.  
 Hemlock, 9", SCR. NBT N25°E, 12.41'  
 Red Maple, 11", SCR. NBT, S79°E, 38.01'  
 Sugar Maple, 13", SCR. NBT, S32°W, 17.11'  
 Sugar Maple, 9" SCR. NBT, N20°W, 3.98'

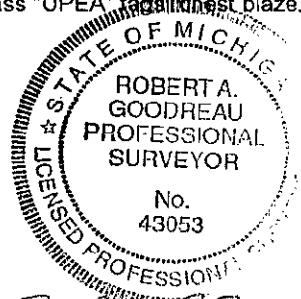

Signed by RAU  
 Surveyor's Michigan License No. 43053

Date 3-30-99