

MICHIGAN
DEPARTMENT OF CONSERVATION
FORESTRY DIVISION

LAND CORNER RECORD

T. 55 N.R. 31 W

RICE LAKE ACCESS


Houghton COUNTY

DESCRIPTION OF CORNER 1/4 Corner between Secs. 17-18

CORNER MONUMENT 1 1/4" Iron Pipe buried

DATE MONUMENT PLACED AND WITNESSED 7/22/65 Distances in Feet

WITNESSES TO CORNER..... 12" W. Pine, S 70° E, 40.6'

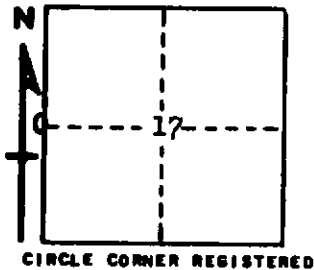

11" W. Pine, S 05° E, 34.3'

AND

DESCRIPTION IN DETAIL AS TO HOW CORNER WAS LOCATED AND IDENTIFIED OR RESTORED.

Distance North to Meander Corner 1003.5'. Set on line with Meander Corners to North and South.

SURVEYOR'S SEAL

Billy D. Buckler
SIGNED Billy D. Buckler DATE 3/24/1966
REGISTERED LAND SURVEYOR