

JAN 09 1998

SECTION

APPROVED LAND CORNER P.A. 345 OF 1990 Houghton County

Ronald W. Counts DEC 10, 1997

LAND CORNER RECORDATION CERTIFICATE Filing Requirement of Act 74, Mich. P.A. 1970

For corners in Houghton (County)

Located In:

Corner Code #

NANCY FENILI 12/11/97

HOUGHTON COUNTY

11:21

LC 3/ 448 PAU Fee: 11.00

Page 1 of 2

- 1. Public Land Survey T 55N R 32W T 55N R 32W T R T R
2. Property Controlling in Section S T R S T R
3. Miscellaneous Property in Section S T R S T R

- D-1 C-1

Register of Deeds Stamp & File Number

- 4. Lot No. , Recorded Plat
5. Private Claims


Grid table with columns A-L and rows 2-13. Cell (2,5) contains 'C-1'.

I, Ronald S. Haataja, in a field survey on October, 19 97, do hereby certify that under requirements of P.A. 74, Michigan P.A. of 1970, the corner points mentioned in lines 1 and 2 above were in conformance with regulations and rules therefore as required in the current manual of survey instructions of the United States Department of the Interior, Bureau of Land Management or by a decree of a Court of Law and/or that the corner points mentioned in lines 3, 4 and 5 above were in conformance with the rules of the Michigan Board of Professional Surveyors or by a Decree of a Court of Law; established, re-established, monumented, re-monumented, recovered, found as expressed below:

NOTE: Not more than 4 corners, all in the same town and range, may be recorded on this certificate.

A. Description of original monument and accessories and/or subsequent restoration:

- (D-1) N1/4 Cor. Sec. 5 not set in original survey S1/4 Cor. Sec. 32 T56N-R32W 40.00 set Qr. Post Sugar 8 N15°E 11, W. Pine N69°W 13
(C-1) NW Cor. Sec. 5 SW Cor. Sec. 32 T56N-R32W 80.00 Set Post Cor. of Sections 31 & 32 Y. Birch 14 N42°E 16, Cedar 10 N63°W 21

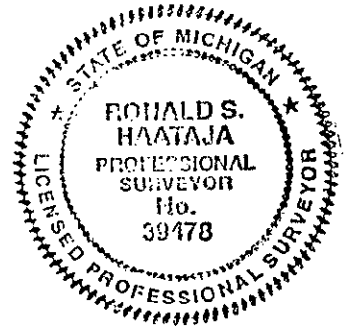

B. Description of corner evidence found and/or method applied in restoring or reestablishing corner:

- (D-1) Found according to LCRC 843 Vol. 2
(C-1) Found 3/4" iron pin in monument box which agrees with recorded assessor's plat of Stamp Mill East. Also found according to LCRC 677 Vol. 2 and agrees with recorded plat of M. Neumann's Addition to Torch Lake City.

C. Description of monument for corner and accessories established to perpetuate locating the position of the corner:

- (D-1) N1/4 Cor. Sec. 5 Fnd. 7/8" Hex Drill Rod Existing witnesses: SE Cor. log shed N84°E 6.03', Util. Pole S86°E 75.45', Util. Pole S08°W 132.95', SW Cor. log shed N82°W 16.52', Added witness: Util. Pole S43°E 130.01' Note: Courses are compass bearings. Existing Util. Pole witnesses have nail and tag #13034 in side. Shed has nail in bottom log at corners. Added Util. Pole witness has nail and tag #39478 in side. See back for remon. cap details.
(C-1) NW Cor. Sec. 5 Fnd. 3/4" iron pin in monument box Witnesses: Util. Pole with Tag #39478 S34°W 46.10', Util. Pole with tag #39478 N31°W 35.10', Util. Pole with tag #24591 N35°E 33.80', Util. Pole with tag #24591 S35°E 34.84'

Signed by Ronald S. Haataja Date November 25, 1997

Surveyor's Michigan License No. 39478

3-17-8
LC

(D-1) N1/4 Cor. Section 5 7/8" Hex Drill Rod found
Drove 1-5/8" O.D. Pipe over 7/8" hex drill rod and cemented
in brass remon. cap and stamped T56-R32
1/4cor | 32
 5 1997
T55-R32

(C-1) NW Cor. Section 5 Found 3/4" iron pin in monument box
Drove 1-1/2" Pipe over 3/4" pin and cemented in brass remon.
cap and stamped. T56-R32
 31 | 32
 6 | 5 1997
T55-R32

00777

RECORDED
INDEXED
MAY 19 1997