

SURVEY & REMONUMENTATION

JUL 23 1999

SECTION

APPROVED LAND CORNER  
P.A. 315 OF 1990  
Houghton County

April 20, 1999  
Robert W. Camp

LAND CORNER RECORDATION CERTIFICATE  
Filing Requirement of Act 74,  
Mich. P.A. 1970

For corners in

Houghton County  
(County)

Located in:

Corner Code #

MARY SCHOOS 05/05/99 2  
HOUGHTON COUNTY, REGISTER 15:07  
LC 3/ 594 PAJ Fee: 9.00  
Page 1 of 1

- 1. Public Land Survey Section 32 T 55N R 32W C-13 SW Corner Section 32
- Section 5 T 54N R 32W C-1 (NW Corner Section 5)
- 2. Property Controlling S T R
- in Section S T R
- 3. Miscellaneous S T R
- Property in Sec. S T R

Register of Deeds Stamp & File Number

- 4. Lot No. \_\_\_\_\_, Recorded Plat \_\_\_\_\_
- 5. Private Claims \_\_\_\_\_

I, Michael T. Drewyor, in a field survey on December 4, 19 97 do hereby state that under requirements of P.A. 74, Michigan P.A. of 1970, the corner points mentioned in lines 1 and 2 above were in conformance with regulations and rules therefore as required in the current manual of survey instructions of the United States Department of the Interior, Bureau of Land Management or by a decree of a Court of Law and /or that the corner points mentioned in lines 3, 4 and 5 above were in conformance with the rules of the Michigan Board of Land Surveyors or by a Decree of a Court of Law; established, re-established, monumented, recovered, found as expressed below:

NOTE: Not more than 2 corners, all in the same town and range, may be recorded on this certificate.

A. Description of original monument and accessories and/or subsequent restoration:

SE 1/4-Corner, Section 31: At 79.00 chains (meas. from W) set section post corner of Sections 31 & 32.

White Pine 10, N 38° W, 04  
Fir 8, N 62° E, 07

No evidence of original monument or accessories found. This line was originally surveyed by Deputy Surveyor William Ives between July 13, 1845 & July 24, 1845.

B. Description of corner evidence found and/or method applied in restoring or reestablishing corner:

Found 1" solid iron rod 5" above grade 5' south of the southerly edge of gravel driveway. This corner is located in the yard at Fire No. 139 on Bootjack Road.

C. Description of monument for corner and accessories established to perpetuate locating the position of the corner:


All witness points in trees are PK nails and washers.  
SW Corner of Section - Found 1" ID iron pipe (description above).

Witnesses:

- N 10° E, 22.21 ft., Power Pole
- N 63° E, 1.76 ft., 22" Pine
- S 04° E, 21.22 ft., 15" Pine
- N 74° W, 6.43 ft., 20" White Birch

Signed by Michael T. Drewyor Date April 13, 1999

Surveyor's Michigan License No. 24245

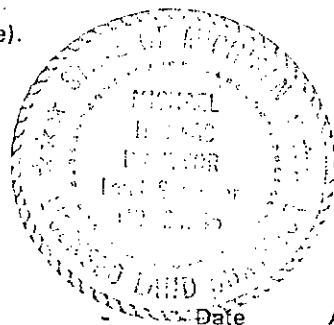

	A	B	C	D	E	F	G	H	I	J	K	L	M
1													
2	6		5		4		3		2		1		
3													
4	7		8		9		10		11		12		
5													
6	18		17		16		15		14		13		
7													
8	19		20		21		22		23		24		
9													
10	30		29		28		27		26		25		
11													
12	31		32		33		34		35		36		
13													