

JAN 09 1998

Robert W. Aantaa
DEC. 10, 1997

LAND CORNER RECORDATION CERTIFICATE
Filing Requirement of Act 74, Mich. P.A. 1970

SECTION

For corners in
Houghton
(County)

Located In:

Corner Code #

NANCY FENILI 12/11/97

HOUGHTON COUNTY

11:24

LC 3/ 457 PAU Fee: 11.00


Page 1 of 2

1. Public Land Survey T 55N R 32W
T 55N R 32W
T _____ R _____
T _____ R _____
2. Property Controlling S _____ T _____ R _____
in Section S _____ T _____ R _____
3. Miscellaneous S _____ T _____ R _____
Property in Section S _____ T _____ R _____

D-5
E-5

Register of Deeds Stamp & File Number

4. Lot No. _____, Recorded Plat _____
5. Private Claims _____

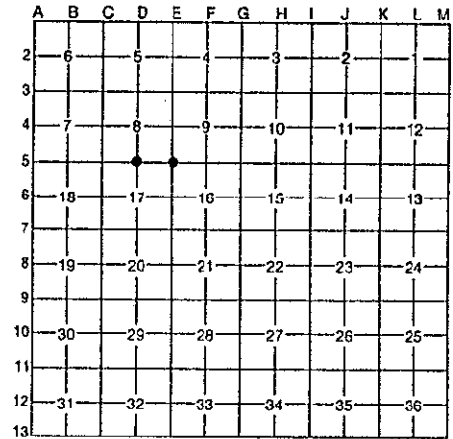


I, Ronald S. Haataja field survey on October, 19 97, do hereby certify that under requirements of P.A. 74, Michigan P.A. of 1970, the corner points mentioned in lines 1 and 2 above were in conformance with regulations and rules therefore as required in the current manual of survey instructions of the United States Department of the Interior, Bureau of Land Management or by a decree of a Court of Law and/or that the corner points mentioned in lines 3, 4 and 5 above were in conformance with the rules of the Michigan Board of Professional Surveyors or by a Decree of a Court of Law; established, re-established, monumented, re-monumented, recovered, found as expressed below:

NOTE: Not more than 4 corners, all in the same town and range, may be recorded on this certificate.

A. Description of original monument and accessories and/or subsequent restoration:

(D-5) S 1/4 Cor. Section 8, T55N-R32W
Wm. Ives set wooden post in 1846. References: 10"
Hemlock S31°W 18 lks. 8" Fir N44°E 19 lks.

(E-5) SE Cor. Section 8, T55N-R32W
Wooden post set by Wm. Ives in 1846. References: 6"
Sugar Maple S24°E 18lks., 13" Sugar Maple N22°W 23 lks.
No trace of original post.

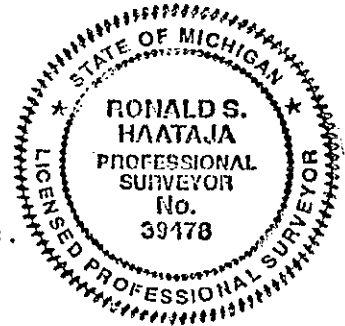

B. Description of corner evidence found and/or method applied in restoring or reestablishing corner:

(D-5) S 1/4 Cor. Section 8, T55N-R32W
Found 3" thin wall pipe according to LCR Vol. 1, page 599

(E-5) SE Cor. Section 8, T55N-R32W
Found 1/2" Rebar in monument box according to LCR Vol. 1, page 599

C. Description of monument for corner and accessories established to perpetuate locating the position of the corner:

(D-5) S 1/4 Cor. Section 8, T55N-R32W, Fnd. 3" O.D. thin wall pipe
Witnesses: 5" W. Birch S63°E 9.70', 14" W. Birch S49°W 18.35',
5" Balsam N65°W 30.05', 5" Maple N07°E 17.58', 148' West to
centerline of Bootjack Road.

(E-5) SE Cor. Section 8, T55N-R32W, Fnd. 1/2" rebar in monument box
Witnesses: Prop. Cor. (3/4" capped pipe) N02°E 40.35', Util. Guy
Pole N21°W 135.59', Utility Pole S44°W 52.37', Utility Pole
S05°E 206.32', 6.3' North of Rice Lake Road centerline and
intersecting with centerline of Codere road (gravel).

Note: Brass tags with PS#39478 are nailed into side of witness trees and utility poles. See back for remon. cap details.

Signed by Ronald S. Haataja Date November 25, 1997

Surveyor's Michigan License No. 39478