

JAN 09 1998

LAND CORNER RECORDATION CERTIFICATE  
Filing Requirement of Act 74, Mich. P.A. 1970

SECTION

For corners in

HOUGHTON  
(County)

Located In:

Corner Code #

NANCY FENILI 12/11/97

HOUGHTON COUNTY

11:18

LC 3/ 440 PAU Fee: 9.00

Page 1 of 1

1. Public Land Survey

T<sub>55N</sub> R<sub>22W</sub> (07) D-7  
T<sub>55N</sub> R<sub>22W</sub> C7

2. Property Controlling  
in Section

S T R

3. Miscellaneous

S T R

Property in Sec.

S T R

Register of Deeds Stamp & File Number

4. Lot No. \_\_\_\_\_, Recorded Plat \_\_\_\_\_  
5. Private Claims \_\_\_\_\_

November 20, 1997

I, Steven C. Hein, in a field survey on \_\_\_\_\_, 19\_\_\_\_ do hereby state that under requirements of P.A. 74, Michigan P.A. of 1970, the corner points mentioned in lines 1 and 2 above were in conformance with regulations and rules therefore as required in the current manual of survey instructions of the United States Department of the Interior, Bureau of Land Management or by a decree of a Court of Law and /or that the corner points mentioned in lines 3, 4 and 5 above were in conformance with the rules of the Michigan Board of Land Surveyors or by a Decree of a Court of Law; established, re-established, monumented, recovered, found as expressed below:

NOTE: Not more than 2 corners, all in the same town and range, may be recorded on this certificate.

	A	B	C	D	E	F	G	H	I	J	K	L	M
1													
2	6		5		4		3		2		1		
3													
4	7		8		9		10		11		12		
5													
6	10		17		16		15		14		13		
7			•	•									
8	19		20		21		22		23		24		
9													
10	30		29		28		27		26		25		
11													
12	31		32		33		34		35		36		
13													

A. Description of original monument and accessories and/or subsequent restoration:

(07) From Original notes: 39.97 Set qr. Section post; Maple 12 N70W 23; Black Ash 8 S40E 33. No evidence of original corner. On October 6, 1976 John I Haataja, P.S. 19833 set a 3/4" pipe for the quarter corner, replacing a bent 1 1/4" pipe. On September 10, 1996 survey S.C Hein, P.S. 32336 reset the quarter corner (3/4" pipe gone) from found witnesses by J.I. Haataja: 12" R. Maple S60W 47.22'; 9" R. Maple S12W 27.73'.

(C7) From Original notes: 80.00 Set post Corner of sections 17, 18, 19, 20; Hemlock 11 S31W 30; Maple 7 N46E 13. No evidence of original corner. Corner was found and recorded by Robert W. Crampton, P.S. 24591 in Liber 3 of L.C.R.C., page 119.

B. Description of corner evidence found and/or method applied in restoring or reestablishing corner:

(07) Found 1/2" capped pin. P.S. 32336 6" below gravel road surface, 1.0' South of Bonini Road centerline as previously recorded in Liber 3 of L.C.R.C., page 375. Replaced found capped pin with Houghton County Remonumentation brass cap.

(C7) Found 1" iron pin as recorded. Found witnesses: 8" balsam S53W 77.67'; Utility Pole N55W 57.45'; 12" Maple N52E 70.26'; 1/2" rebar North 199.27'. Replaced 1" pin with Houghton County Remonumentation brass cap.

C. Description of monument for corner and accessories established to perpetuate locating the position of the corner:

(07) Set 2 1/4" Brass Cap on 3/4" pipe, 6" below gravel road surface.

Witnesses of record:

12" R. Maple S60W 47.22' (P.K.)

9" R. Maple S12W 27.73' (P.K.)

7" R. Maple N61E 42.88' (tag #32336)

4" H. Maple S49E 42.63' (tag #32336)

(C7) Set 2 1/4" Brass Cap on 3/4" pipe


Witnesses of record:

1/2" Rebar North 199.27'

12" Maple N52E 70.26' (70.20' meas.)

8" Balsam S53W 77.67' (77.58' meas.)

Util. Pole N55W 57.45' (57.38' meas.)

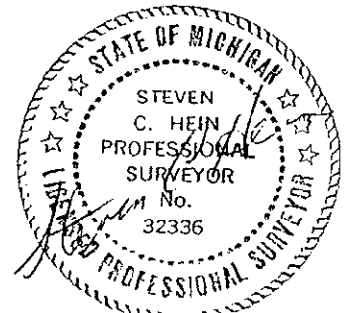

Signed by Steven C. Hein

Date NOV. 24, 1997

Surveyor's Michigan License No. 32336