SURVEY &
REMONUMENTATION

JUL 2 3 1999

SECTION

APPROVED LAND CORNER
P.A. 345 of 1990
Houghton County

April 30, 1999
Robert W. Crumpton

LAND CORNER RECORDATION CERTIFICATE
Filing Requirement of Act 74,
Mich. P.A. 1970

MARY SCHOOS 05/05/99 2
HOUGHTON COUNTY, REGISTER 15:07
LC 3/ 593 PAU Fee: 9.00
Page 1 of 1

For corners in

Houghton County (County) Located In: Corner Code #

1. Public Land Survey Section 32		T 55N	R 32W	D-13 (S ¼ Corner Sec. 32)
		T____	R____	
	Section 5	T 54N	R 32W	D-1 (N 1/4 Corner Sec. 5
		T____	R____	
2. Property Controlling	S____	T____	R____	
in Section	S____	T____	R____	
3. Miscellaneous	S____	T____	R____	
Property in Sec.	S____	T____	R____	

Register of Deeds Stamp & File Number

4. Lot No. _____ , Recorded Plat _____
5. Private Claims _____

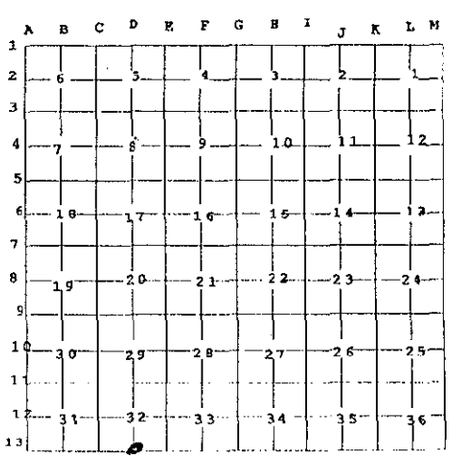

I, Michael T. Drewyor , in a field survey on December 18 , 19 97 do hereby state that under requirements of P.A. 74, Michigan P.A. of 1970, the corner points mentioned in lines 1 and 2 above were in conformance with regulations and rules therefore as required in the current manual of survey instructions of the United States Department of the Interior, Bureau of Land Management or by a decree of a Court of Law and /or that the corner points mentioned in lines 3, 4 and 5 above were in conformance with the rules of the Michigan Board of Land Surveyors or by a Decree of a Court of Law; established, re-established, monumented, recovered, found as expressed below:

NOTE: **Not more than 2 corners, all in the same town and range, may be recorded on this certificate.**

A. Description of original monument and accessories and/or subsequent restoration:

S ¼ Corner, Section 32: At 40.00 chains (measure from W), set ¼ section post.

Yellow Birch 12, N 43° W, 31
Yellow Birch 20, N 61° E, 25

No evidence of original monument or accessories found. This line was originally surveyed by Deputy Surveyor William Ives between July 13, 1845 & July 24, 1845.

B. Description of corner evidence found and/or method applied in restoring or reestablishing corner:

No evidence of corner position found. Corner restored by single proportionate measurement on line between the southwest corner and the southeast of Section 32.

C. Description of monument for corner and accessories established to perpetuate locating the position of the corner:

All witness points in trees are PK nails and washers.

South ¼ Corner – Set ½" iron.

Witnesses:

N 22° E,	29.61 ft.,	7" Fir
S 73° E,	12.86 ft.,	11" Fir
S 22° W,	28.09 ft.,	16" Fir
N 80° W,	18.41 ft.,	14" Fir

Signed by Michael T. Drewyor Date April 13, 1999

Surveyor's Michigan License No. 24245

FORM APPROVED BY MICHIGAN STATE BOARD OF PROFESSIONAL SURVEYORS, JAN. 28, 1971

REVISED MAY 14, 1975
REVISED JAN., 1983
REVISED OCT., 1995

By: Hitch, Inc., P.C., Houghton, MI
Job #97012