APPROVED LAND CORNER
P.A. 345 OF 1990
Houghton County
Robert W. Compton
Dec. 10, 1997

SURVEY & REMONUMENTATION

JAN 0 9 1998

SECTION

LAND CORNER RECORDATION CERTIFICATE

Filing Requirement of Act 74, Mich. P.A. 1970

For corners in Houghton (County) Located In: Corner Code #

NANCY FENILI 12/11/97
HOUGHTON COUNTY 11:24
LC 3/ 457 PAU Fee: 11.00
Page 1 of 2

1. Public Land Survey		T 55N R 32W	D-5
		T 55N R 32W	E-5
		T ___ R ___	
		T ___ R ___	
2. Property Controlling	S ___	T ___ R ___	
in Section	S ___	T ___ R ___	
3. Miscellaneous	S ___	T ___ R ___	
Property in Section	S ___	T ___ R ___	

Register of Deeds Stamp & File Number

4. Lot No. _____, Recorded Plat _____
5. Private Claims _____

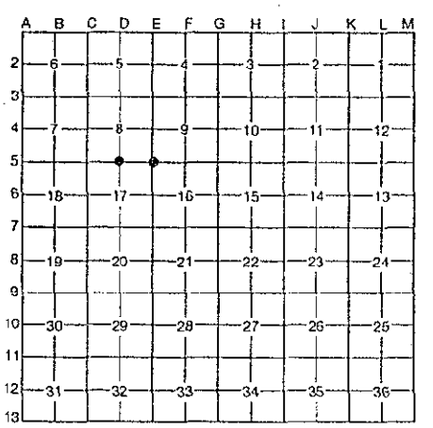

I, Ronald S. Haataja a field survey on October, 19 97, do hereby certify that under requirements of P.A. 74, Michigan P.A. of 1970, the corner points mentioned in lines 1 and 2 above were in conformance with regulations and rules therefore as required in the current manual of survey instructions of the United States Department of the Interior, Bureau of Land Management or by a decree of a Court of Law and/or that the corner points mentioned in lines 3, 4 and 5 above were in conformance with the rules of the Michigan Board of Professional Surveyors or by a Decree of a Court of Law; established, re-established, monumented, re-monumented, recovered, found as expressed below:

NOTE: Not more than 4 corners, all in the same town and range, may be recorded on this certificate.

A. Description of original monument and accessories and/or subsequent restoration:

(D-5) S 1/4 Cor. Section 8, T55N-R32W
Wm. Ives set wooden post in 1846. References: 10" Hemlock S31°W 18 lks. 8" Fir N44°E 19 lks.

(E-5) SE Cor. Section 8, T55N-R32W
Wooden post set by Wm. Ives in 1846. References: 6" Sugar Maple S24°E 18lks., 13" Sugar Maple N22°W 23 lks. No trace of original post.

STATE OF MICHIGAN
RONALD S. HAATAJA
PROFESSIONAL SURVEYOR
No. 39478
LICENSED PROFESSIONAL SURVEYOR

B. Description of corner evidence found and/or method applied in restoring or reestablishing corner:

(D-5) S 1/4 Cor. Section 8, T55N-R32W
Found 3" thin wall pipe according to LCR Vol. 1, page 599

(E-5) SE Cor. Section 8, T55N-R32W
Found 1/2" Rebar in monument box according to LCR Vol. 1, page 599

C. Description of monument for corner and accessories established to perpetuate locating the position of the corner:

(D-5) S 1/4 Cor. Section 8, T55N-R32W, Fnd. 3" O.D. thin wall pipe Witnesses: 5" W. Birch S63°E 9.70', 14" W. Birch S49°W 18.35', 5" Balsam N65°W 30.05', 5" Maple N07°E 17.58', 148' West to centerline of Bootjack Road.

(E-5) SE Cor. Section 8, T55N-R32W, Fnd. 1/2" rebar in monument box Witnesses: Prop. Cor.(3/4" capped pipe) N02°E 40.35', Util. Guy Pole N21°W 135.59', Utility Pole S44°W 52.37', Utility Pole S05°E 206.32', 6.3' North of Rice Lake Road centerline and intersecting with centerline of Codere road (gravel).

Note: Brass tags with PS#39478 are nailed into side of witness trees and utility poles. See back for remon. cap details.

Signed by Ronald S. Haataja Date November 25, 1997

Surveyor's Michigan License No. 39478

FORM APPROVED BY MICHIGAN STATE BOARD OF PROFESSIONAL SURVEYORS, JAN. 28, 1971
REVISED MAY 14, 1975
REVISED JAN., 1983