

JAN 09 1998

LAND CORNER RECORDATION CERTIFICATE
Filing Requirement of Act 74, Mich. P.A. 1970

SECTION

For corners in

HOUGHTON
(County)

Located in: Corner Code #

NANCY FENILI 12/11/97
HOUGHTON COUNTY 11:19
LC 3/ 441 PAU Fee: 9.00
Page 1 of 1

- 1. Public Land Survey T 55N R 32W E6
T 55N R 32W E7
T R
T R
- 2. Property Controlling in Section S T R
S T R
- 3. Miscellaneous Property in Sec. S T R
S T R

Register of Deeds Stamp & File Number

- 4. Lot No. _____, Recorded Plat _____
- 5. Private Claims _____

November 20, 1997

I, Steven C. Hein, in a field survey on _____, 19____ do hereby state that under requirements of P.A. 74, Michigan P.A. of 1970, the corner points mentioned in lines 1 and 2 above were in conformance with regulations and rules therefore as required in the current manual of survey instructions of the United States Department of the Interior, Bureau of Land Management or by a decree of a Court of Law and /or that the corner points mentioned in lines 3, 4 and 5 above were in conformance with the rules of the Michigan Board of Land Surveyors or by a Decree of a Court of Law; established, re-established, monumented, recovered, found as expressed below:


A	B	C	D	E	F	G	H	I	J	K	L	M
1												
2	6		5		4		3		2		1	
3												
4	7		8		9		10		11		12	
5												
6	18		17	•	16		15		14		13	
7				•								
8	19		20		21		22		23		24	
9												
10	30		29		28		27		26		25	
11												
12	31		32		33		34		35		36	
13												

NOTE: Not more than 2 corners, all in the same town and range, may be recorded on this certificate.

A. Description of original monument and accessories and/or subsequent restoration:
(E6) From Original notes: 40.00 Set qr. Section Post; Y. Birch 20 N46W 16; Ironwood 10 S55E 11. No evidence of original corner. Reset by John I. Haataja, P.S. 19833 in November 10, 1978 survey, equidistant from Section corners to North and South and on line between.
(E7) From Original notes: 80.00 Set post Corner of Sections 16, 17, 20, 21; Yellow Birch 15 S81W 08; Fir 4 N25E 12. No evidence of original corner.

B. Description of corner evidence found and/or method applied in restoring or reestablishing corner:
(E6) Found 3/4" capped pipe as recorded in Liber 1 of L.C.R.C., page 601. Witnesses of said record: 26" Maple S25W 25.97'; 16" Maple S77W 33.11'; 8" Maple S83E 64.41' all greatly overgrown. Replaced found capped pipe with Houghton County Remonumentation brass cap.
(E7) A 1 1/2" pipe with fences North, South and West was found and used by John I Haataja, P.S. 19833 in an October 5, 1976 survey. Said pipe was subsequently used by S. C. Hein, P.S. 32336 in a survey on September 10, 1996 and recorded in Liber 3 of L.C.R.C., page 377. Replaced found pipe with Houghton County Remonumentation brass cap.

C. Description of monument for corner and accessories established to perpetuate locating the position of the corner:
(E6) Set 2 1/4" Brass Cap on 3/4" pipe
New Witnesses:
4" Y. Birch N60E 39.99'
8" Maple S44E 13.74'
8" Maple S59W 9.44'
6" Maple S36W 5.42'
Witnesses have nail & tag #32336
(E7) Set 2 1/4" Brass Cap on 3/4" pipe
Witnesses of Record:
10" Aspen N37E 0.68'
8" H. Maple S69E 17.67'
10" R. Maple S52W 25.11'
6" H. Maple N54W 42.81'
Witnesses have nail & tag #32336

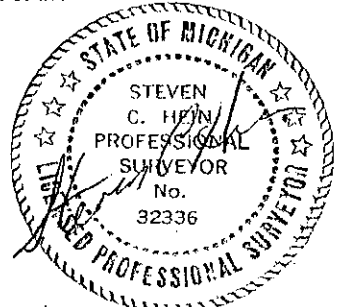

Signed by Steven C. Hein
Surveyor's Michigan License No. 32336

Date Nov. 26, 1997