

JAN 09 1998

SECTION

**APPROVED LAND CORNER
P.A. 345 OF 1990
Houghton County**

Robert W. Crampton
Dec. 10, 1997

**LAND CORNER RECORDATION CERTIFICATE
Filing Requirement of Act 74, Mich. P.A. 1970**

For corners in

HOUGHTON
(County)

Located In:

Corner Code #

NANCY FENILI 12/11/97
HOUGHTON COUNTY
LC 3/ 443 PAU Fee: 11:20
Page 1 of 1 9.00

1. Public Land Survey

T	55N	R	22W	E8
T	55N	R	22W	E9
T		R		
T		R		
S		T	R	
S		T	R	
S		T	R	
S		T	R	

2. Property Controlling in Section

3. Miscellaneous Property in Sec.

4. Lot No. _____, Recorded Plat _____
5. Private Claims _____

Register of Deeds Stamp & File Number

November 20, 1997

I, Steven C. Hein, in a field survey on _____, 19____ do hereby state that under requirements of P.A. 74, Michigan P.A. of 1970, the corner points mentioned in lines 1 and 2 above were in conformance with regulations and rules therefore as required in the current manual of survey instructions of the United States Department of the Interior, Bureau of Land Management or by a decree of a Court of Law and /or that the corner points mentioned in lines 3, 4 and 5 above were in conformance with the rules of the Michigan Board of Land Surveyors or by a Decree of a Court of Law; established, re-established, monumented, recovered, found as expressed below:

NOTE: Not more than 2 corners, all in the same town and range, may be recorded on this certificate.

A	B	C	D	E	F	G	H	I	J	K	L	M
1												
2	6		5		4		3		2		1	
3												
4	7		8		9		10		11		12	
5												
6	18		17		16		15		14		13	
7												
8	19		20		21		22		23		24	
9												
10	30		29		28		27		26		25	
11												
12	31		32		33		34		35		36	
13												

A. Description of original monument and accessories and/or subsequent restoration:


- (E8) From Original notes: 40.00 Set qr. Section post; Sugar 12 S76W 05; Y Birch 8 N21E 30. No evidence of original corner. Corner was found and recorded by Robert W. Crampton, P.S. 24591 in Liber 2 of L.C.R.C., page 815 and used in a survey by him dated November 12, 1991.
- (E9) From Original notes: 80.00 Set Post corner of Sections 20, 21, 28, 29; Y. Birch 14 S04W 13; Ironwood 8 N12E 45. No evidence of original corner. A 1/2" spike was accepted as the section corner by J.J. Haataja, P.S. 19833 in a November 10, 1980 survey and again by R.W. Crampton, P.S. 24591 in a November 12, 1991 survey. R. W. Crampton, P.S. recorded the corner in Liber 1 of L.C.R.C., page 897.

B. Description of corner evidence found and/or method applied in restoring or reestablishing corner:

- (E8) Found 1" square pin, bent, 4" below gravel road surface, in centerline of Aittama Road as previously recorded in Liber 2 of L.C.R.C., page 815. Record witnesses found: 4" Maple N41E 71.25'; 8" W. Pine S83E 32.61'; 10" Y. Birch (dead) S85W 36.16'; 8" Maple S40W 51.76'. Replaced 1" square pin with Houghton County Remonumentation brass cap.
- (E9) Found 1/2" spike as recorded, 10" below gravel road surface, in centerline of Aittama Road North, centerline Mud Lake Road West, 1.5' East of centerline Mud Lake Road South, and 5' North of centerline Piehi Road East. Witnesses of Record: Util. Pole N13W 213.20'; Util. Pole S49W 47.70'; 14" Twin Oak S34W 106.75'; Tele. Junction Box N48E 53.15'. Replaced 1/2" spike with Houghton County Remonumentation brass cap.

C. Description of monument for corner and accessories established to perpetuate locating the position of the corner:

- (E8) Set 2 1/4" Brass cap on 3/4" pipe, 9" below gravel road surface
Witnesses of record:
" Maple N41E 71.25' (71.13'meas.)
" W. Pine S83E 32.61' (32.55'meas.)
" Maple N40W 51.76' (51.72'meas.)
New Witness: 8" Hemlock S78W 49.56'
New witness has nail & tag #32336
- (E9) Set 2 1/4" Brass cap on 3/4" pipe, 9" below gravel road surface
New Witnesses:
Treated Fence Cor. Post N46E 62.06'
10" H. Maple S61W 92.91'
8" W. Pine N53W 78.04'
Old Wit: Util. Pole S49W 47.47' (meas.)
New Wit. have nail & tag #32336

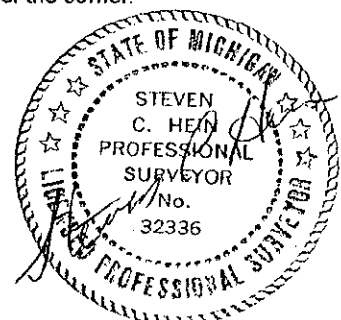

Signed by Steven C. Hein
Surveyor's Michigan License No. 32336

Date Nov. 25, 1997