

JAN 09 1998

SECTION

APPROVED LAND CORNER  
P.A. 345 OF 1990  
Houghton County

Dec 10, 1997  
Robert W. Crampton

LAND CORNER RECORDATION CERTIFICATE  
Filing Requirement of Act 74, Mich. P.A. 1970

For corners in

HOUGHTON

(County)

Located In:

Corner Code #

NANCY FENILI 12/11/97

HOUGHTON COUNTY

LC 3/ 447 PAU Fee:

11:21

9.00

Page 1 of 1

1. Public Land Survey

T 55N R 32W

E11

T 55N R 32W

011

T R

T R

2. Property Controlling  
in Section

S T R

S T R

3. Miscellaneous  
Property in Sec.

S T R

S T R

Register of Deeds Stamp & File Number

4. Lot No. \_\_\_\_\_, Recorded Plat \_\_\_\_\_

5. Private Claims \_\_\_\_\_

November 20, 1997

I, Steven C. Hein, in a field survey on \_\_\_\_\_, 19\_\_\_\_ do hereby state that under requirements of P.A. 74, Michigan P.A. of 1970, the corner points mentioned in lines 1 and 2 above were in conformance with regulations and rules therefore as required in the current manual of survey instructions of the United States Department of the Interior, Bureau of Land Management or by a decree of a Court of Law and/or that the corner points mentioned in lines 3, 4 and 5 above were in conformance with the rules of the Michigan Board of Land Surveyors or by a Decree of a Court of Law; established, re-established, monumented, recovered, found as expressed below:

NOTE: Not more than 2 corners, all in the same town and range, may be recorded on this certificate.

A	B	C	D	E	F	G	H	I	J	K	L	M
1												
2	6	5	4	3	2	1						
3												
4	7	8	9	10	11	12						
5												
6	18	17	16	15	14	13						
7												
8	19	20	21	22	23	24						
9												
10	30	29	28	27	26	25						
11												
12	31	32	33	34	35	36						
13												

A. Description of original monument and accessories and/or subsequent restoration:

(E11) From Original notes: 80.00 Set post corner of Sections 28, 29, 32, 33; Spruce 8 S50E 20; Yellow Birch 7 N15E 28. No evidence of original corner.

(011) From Original notes: 40.00 Set qr. Section post; Sugar 10 N27E 14; W. Pine 36 S35W 19. No evidence of original corner. A 1/2" pipe was found in an East/West fenceline by Robert W. Crampton, P.S. 24591 and recorded by him in Liber 1 of L.C.R.C., page 871. Said pipe was used in numerous surveys by Crampton, Haataja and Hein.

B. Description of corner evidence found and/or method applied in restoring or reestablishing corner:


(E11) Found 3/4" square pin, 8" below gravel road surface, in centerline of Mud Lake Post Road to South, 3' West of Mud Lake Road centerline to North, and on Southerly edge of gravel of Mud Lake Road to East. Fenceline to West. Position fits well with corners to North and West. Replaced 3/4" square pin with Houghton County Remonumentation brass cap.

(011) Found 1/2" pipe in an East/West fenceline as recorded by R.W. Crampton, P.S. 24591 in Liber 1 of L.C.R.C., page 871. Found Witnesses: 6" Maple West 16.38'; 8" W. Birch N72E 10.12'; 14" Aspen South 5.51'; Twin 10" Maple S70W 16.78'. Replaced 1/2" pipe with Houghton County Remonumentation brass cap.

C. Description of monument for corner and accessories established to perpetuate locating the position of the corner:

(E11) Set 2 1/4" Brass cap on 3/4" pipe, 11" below gravel road surface  
Witnesses:  
8" N. Maple S49E 63.90'  
5" W. Birch S22W 68.21'  
10" Y. Birch N77W 30.10'  
10" R. Maple N39W 63.86'  
Witnesses have nail & tag #32336

(011) Set 2 1/4" Brass cap on 3/4" pipe  
New Witnesses:  
8" W. Pine N75E 23.84'  
7" R. Maple S31E 4.95'  
9" R. Maple S62W 16.64'  
5" W. Birch N05W 34.69'  
New witnesses have nail & tag #32336

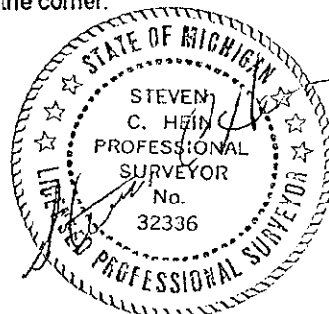

Signed by Steven C. Hein  
Surveyor's Michigan License No. 32336

Date Nov. 25, 1997