

Robert W. Campbell  
DEC. 10, 1997

SEP 17 1999

LAND CORNER RECORDATION CERTIFICATE  
Filing Requirement of Act 74, Mich. P.A. 1970

SECTION

For corners in

HOUGHTON

(County)

Located In:

Corner Code #

NANCY FENILI 12/11/97

HOUGHTON COUNTY

11:18

LC 3/ 439 PAU Fee: 9.00

Page 1 of 1

1. Public Land Survey

T 55N R 32W

MC C11-D11 Z -15

T R

T R

Other #15

T R

2. Property Controlling  
in Section

S T R

S T R

3. Miscellaneous  
Property in Sec.

S T R

S T R

Register of Deeds Stamp & File Number

4. Lot No. \_\_\_\_\_, Recorded Plat \_\_\_\_\_

5. Private Claims \_\_\_\_\_

November 20, 1997

I, Steven C. Hein, in a field survey on \_\_\_\_\_, 19\_\_\_\_ do hereby state that under requirements of P.A. 74, Michigan P.A. of 1970, the corner points mentioned in lines 1 and 2 above were in conformance with regulations and rules therefore as required in the current manual of survey instructions of the United States Department of the Interior, Bureau of Land Management or by a decree of a Court of Law and /or that the corner points mentioned in lines 3, 4 and 5 above were in conformance with the rules of the Michigan Board of Land Surveyors or by a Decree of a Court of Law; established, re-established, monumented, recovered, found as expressed below:

NOTE: Not more than 2 corners, all in the same town and range, may be recorded on this certificate.

|    | A | B  | C | D  | E | F  | G | H  | I | J  | K | L  | M |
|----|---|----|---|----|---|----|---|----|---|----|---|----|---|
| 1  |   |    |   |    |   |    |   |    |   |    |   |    |   |
| 2  |   | 6  |   | 5  |   | 4  |   | 3  |   | 2  |   | 1  |   |
| 3  |   |    |   |    |   |    |   |    |   |    |   |    |   |
| 4  |   | 7  |   | 8  |   | 9  |   | 10 |   | 11 |   | 12 |   |
| 5  |   |    |   |    |   |    |   |    |   |    |   |    |   |
| 6  |   | 16 |   | 17 |   | 16 |   | 15 |   | 14 |   | 13 |   |
| 7  |   |    |   |    |   |    |   |    |   |    |   |    |   |
| 8  |   | 19 |   | 20 |   | 21 |   | 22 |   | 23 |   | 24 |   |
| 9  |   |    |   |    |   |    |   |    |   |    |   |    |   |
| 10 |   | 30 |   | 29 |   | 28 |   | 27 |   | 26 |   | 25 |   |
| 11 |   |    |   |    |   |    |   |    |   |    |   |    |   |
| 12 |   | 31 |   | 32 |   | 33 |   | 34 |   | 35 |   | 36 |   |
| 13 |   |    |   |    |   |    |   |    |   |    |   |    |   |

A. Description of original monument and accessories and/or subsequent restoration:  
(MC C11-D11) From Original notes: 75.12 Intersected NE arm of Portage Lake; Set meander post; Black Ash 11 N30E 13; Do 6 S71E 54. No evidence of original corner. Corner position falls in lakefront yard of Kukkonen lot.

B. Description of corner evidence found and/or method applied in restoring or reestablishing corner:

(MC C11-D11) As no evidence of original corner or subsequent survey was found the meander corner was set on line between the found South Quarter corner of Section 29 and the found South Quarter corner of Section 30. Meander Corner bears N89°37'31"W 2306.31' from the S1/4 Corner of Section 29. Set Houghton County Remonumentation brass cap.

C. Description of monument for corner and accessories established to perpetuate locating the position of the corner:

(MC C11-D11) set 2 1/4" Brass cap on 3/4" pipe, 10' West to Portage Lake

Witnesses:


4" Spruce N24E 17.15'

4" W. Birch S82E 31.44'

3" Balsam S57E 86.97'

Post, W. end fence S19E 88.28'

Witnesses have nail & tag #32336

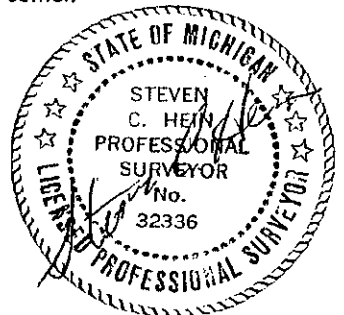

Signed by Steven C. Hein

Date Nov. 25, 1997

Surveyor's Michigan License No. 32336