

MICHIGAN
DEPARTMENT OF CONSERVATION
FORESTRY DIVISION

LAND CORNER RECORD

T. 55 N.R. 32 W


TORCH LAKE ACCESS Houghton COUNTY

DESCRIPTION OF CORNER South West 1/16 Corner of Section 31

CORNER MONUMENT 1" Pipe with 4" Aluminum Cap

DATE MONUMENT PLACED AND WITNESSED 8/17/65

WITNESSES TO CORNER..... 10" Soft Maple (BT), S 72° W, 29.5'

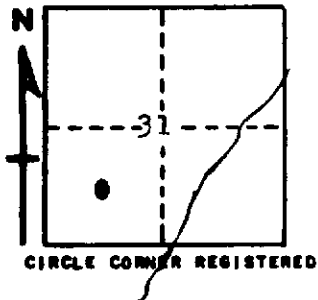

11" Soft Maple Twin (BT), S 64° E, 20.6'

AND

DESCRIPTION IN DETAIL AS TO HOW CORNER WAS LOCATED AND IDENTIFIED OR RESTORED.

This Corner was placed on N-S fence line and South 1/16 line.

SURVEYOR'S SEAL

Billy D. Buckler
SIGNED Billy D. Buckler REGISTERED LAND SURVEYOR DATE 3/25/1966
~~8/17/65~~