APPROVED AS CORNER
Houghton County
Robert W. Crawford
Oct. 28, 1999

LAND CORNER RECORDATION CERTIFICATE

Filing Requirement of Act 74, Mich. P.A. 1970

JAN 2 5 2000

SECTION

For corners in Houghton (County) Located In: Corner Code #

1. Public Land Survey T 55N R 33W A-8
   T ___ R ___
   T ___ R ___
   T ___ R ___
2. Property Controlling S ___ T ___ R ___
   in Section S ___ T ___ R ___
3. Miscellaneous S ___ T ___ R ___
   Property in Section S ___ T ___ R ___

Mary Schoos 1P
Register of Deeds
Houghton County, Register
Page 1 of 1 LC 4/59
PAU Date 12/30/1999 Time 10:47:05
FEE. 9.00

Register of Deeds Stamp & File Number

4. Lot No. _____, Recorded Plat _____
5. Private Claims _____

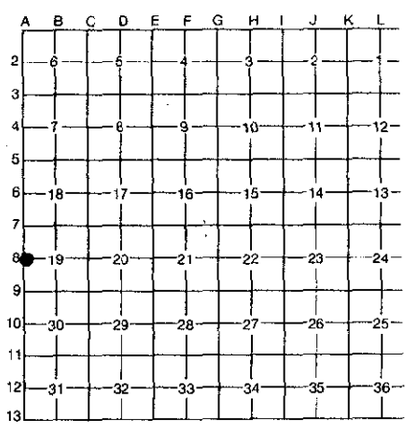

I, Ronald S. Haataja, in a field survey on July 20, 1998, do hereby certify that under requirements of P.A. 74, Michigan P.A. of 1970, the corner points mentioned in lines 1 and 2 above were in conformance with regulations and rules therefore as required in the current manual of survey instructions of the United States Department of the Interior, Bureau of Land Management or by a decree of a Court of Law and/or that the corner points mentioned in lines 3, 4 and 5 above were in conformance with the rules of the Michigan Board of Professional Surveyors or by a Decree of a Court of Law; established, re-established, monumented, re-monumented, recovered, found as expressed below:

NOTE: Not more than 4 corners, all in the same town and range, may be recorded on this certificate.

A. **Description of original monument and accessories and/or subsequent restoration:**

(A-8) West 1/4 Corner Section 19, T55N-R33W
40.00 Set Quarter Section Post
References: Sugar 8" S15°W 31 lks.
Do 14" N42°E 16 lks.

B. **Description of corner evidence found and/or method applied in restoring or reestablishing corner:**

(A-8) West 1/4 Corner Section 19, T55N-R33W
No evidence of original corner found.
I reset the corner midway and on line between the Section Corners North and South during a survey that I did in 1998.
I set a 1/2" capped rebar P.S. # 39478.

C. **Description of monument for corner and accessories established to perpetuate locating the position of the corner:**

(A-8) West 1/4 Corner Section 19, T55N-R33W
1/2" capped rebar. Drove 2" iron pipe over rebar and cemented on a brass Houghton County Remonumentation cap
Witnesses: Brass tags P.S. # 39478 in side of trees
10" Maple N07°E 36.92' 10" Maple N33°W 24.38'
4" Maple N83°W 14.37' 4" Birch S14°E 25.34'

STATE OF MICHIGAN
RONALD S. HAATAJA
PROFESSIONAL SURVEYOR
No. 39478
LICENSED PROFESSIONAL SURVEYOR

Signed by Ronald S. Haataja Date October 20, 1999

Surveyor's Michigan License No. 39478

FORM APPROVED BY MICHIGAN STATE BOARD OF PROFESSIONAL SURVEYORS, JAN. 28, 1971
REVISED MAY 14, 1975
REVISED JAN., 1983