

**SURVEY & REMONUMENTATION**

**JAN 09 1998**

**SECTION**

**LAND CORNER RECORDATION CERTIFICATE**  
Filing Requirement of Act 74, Mich. P.A. 1970

SEPT. 23, 1997  
*Robert W. Crampton*  
For corners in  
HOUGHTON  
(County)

Located In: \_\_\_\_\_ Corner Code # \_\_\_\_\_

- |                                      |                           |                                |
|--------------------------------------|---------------------------|--------------------------------|
| 1. Public Land Survey                | T <u>55N</u> R <u>34W</u> | <u>M-9, J-9.</u><br><u>A-9</u> |
|                                      | T <u>55N</u> R <u>33W</u> |                                |
|                                      | T _____ R _____           |                                |
|                                      | T _____ R _____           |                                |
|                                      | T _____ R _____           |                                |
| 2. Property Controlling in Section   | S _____ T _____ R _____   |                                |
|                                      | S _____ T _____ R _____   |                                |
| 3. Miscellaneous Property in Section | S _____ T _____ R _____   |                                |
|                                      | S _____ T _____ R _____   |                                |

NANCY FENILI 09/23/97 #  
HOUGHTON COUNTY 14:35  
LC 3/ 432 PAU Fee: 9.00  
Page 1 of 1

Register of Deeds Stamp & File Number

4. Lot No. \_\_\_\_\_, Recorded Plat \_\_\_\_\_  
5. Private Claims \_\_\_\_\_

I, R. W. CRAMPTON, in a field survey on JULY 28 (M-9, A-9) & JUNE 4 (J-9), 92  
do hereby certify that under requirements of P.A. 74, Michigan P.A. of 1970, the corner points mentioned in lines 1 and 2 above were in conformance with regulations and rules therefore as required in the current manual of survey instructions of the United States Department of the Interior, Bureau of Land Management or by a decree of a Court of Law and/or that the corner points mentioned in lines 3, 4 and 5 above were in conformance with the rules of the Michigan Board of Professional Surveyors or by a Decree of a Court of Law; established, re-established, monumented, re-monumented, recovered, found as expressed below:


**NOTE: Not more than 4 corners, all in the same town and range, may be recorded on this certificate.**

A	B	C	D	E	F	G	H	I	J	K	L	M
2	6	5	4	3	2							
3												
4	7	8	9	10	11	12						
5												
6	18	17	16	15	14	13						
7												
8	19	20	21	22	23	24						
9												
10	30	29	28	27	26	25						
11												
12	31	32	33	34	35	36						
13												

**A. Description of original monument and accessories and/or subsequent restoration:**

*M-9 55-34 & A-9 55-33 NE CORNER SECTION 25, 80.00 SET POST CORNER OF SECTION 24 & 25, B. ASH 10 S41W 16, B. ASH 6 N46E 21.*

*J-9 N ¼ COR. SECTION 26, 39.76 SET QR. SECTION POST, SUGAR 6 N83E 10, SUGAR 12 N68W 25.*

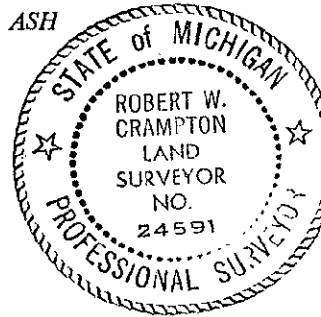

**B. Description of corner evidence found and/or method applied in restoring or reestablishing corner:**

*M-9 55-34 & A-9 55-33 NE CORNER SECTION 25, FOUND R.R. SPIKE IN CENTERLINE OF ARCADIAN RD, H. C. R. C. STA. 44+57.02 P. O. T. & IN CENTERLINE OF DIRT ROAD TO SOUTH, FD WITNESS: NAIL IN FENCE POST N40E 41.79', REPLACED WITH ½" IRON PIPE WITH 2 ¼" BRASS CAP. PREVIOUSLY RECORDED BY STEVEN C. HEIN, LIBER 2, PAGE 879.*

*J-9 N ¼ COR. SECTION 26, FOUND 1 ½" DIA. HOLE IN 24" SP. ROCK FLUSH WITH GROUND, 6' NORTH OF OLD FENCELINE AS RECORDED IN MAY, 1949 MINING NOTES, SET ¾" IRON PIPE WITH 2 ¼" BRASS CAP IN DRILL HOLE. PREVIOUSLY RECORDED BY STEVEN C. HEIN, LIBER 2, PAGE 865.*

**C. Description of monument for corner and accessories established to perpetuate locating the position of the corner:**

*M-9 55-34 & A-9 55-33 NE CORNER SECTION 25, ½" IRON PIPE WITH BRASS CAP, WITNESSED WITH SURVEY TAG NAILED TO: UTILITY POLE S33°W 64.75', UTILITY POLE S52°W 41.25', UTILITY POLE N4° W 41.99', NAIL IN FENCE POST N41°E 41.95'.  
(NOTE: COURSES ARE COMPASS BEARINGS. UTILITY POLES HAVE NAIL & TAG # 32336 IN SIDE.)*

*J-9 N ¼ COR. SECTION 26, ¾" IRON PIPE WITH BRASS CAP, WITNESSED WITH SURVEY TAG NAILED TO: 6" ASPEN TREE N60°E 6.12', 8" JACK PINE TREE S29°E 37.15', 5" JACK PINE TREE S30°W 29.58', POWER POLE N38°E 62.39'.  
(NOTE: WITNESSES HAVE FACE BLAZE AND SIDE BLAZE WITH NAIL & TAG # 32336. COURSES ARE COMPASS BEARINGS.)*

Signed by *Robert W. Crampton* Date Aug. 26, 1997  
Surveyor's Michigan License No. 24591