

JAN 09 1998

LAND CORNER RECORDATION CERTIFICATE
Filing Requirement of Act 74, Mich. P.A. 1970

SECTION

For corners in
HOUGHTON
(County)

Located In: Corner Code #

- 1. Public Land Survey T 55N R 34W
T 55N R 33W
T _____ R _____
T _____ R _____
- 2. Property Controlling S _____ T _____ R _____
in Section S _____ T _____ R _____
- 3. Miscellaneous S _____ T _____ R _____
Property in Section S _____ T _____ R _____

M-10, M-11
A-10, A-11

NANCY FENILI 09/23/97
HOUGHTON COUNTY 14:34
LC 3/ 429 PAU Fee: 9.00
Page 1 of 1

Register of Deeds Stamp & File Number

- 4. Lot No. _____, Recorded Plat _____
- 5. Private Claims _____

(M-10 /A-10) (M-11 /A-11)
JULY 30 & JUNE 30

I, R.W. CRAMPTON, in a field survey on _____, 19 92
do hereby certify that under requirements of P.A. 74, Michigan P.A. of 1970, the corner points mentioned in lines 1 and 2 above were in conformance with regulations and rules therefore as required in the current manual of survey instructions of the United States Department of the Interior, Bureau of Land Management or by a decree of a Court of Law and/or that the corner points mentioned in lines 3, 4 and 5 above were in conformance with the rules of the Michigan Board of Professional Surveyors or by a Decree of a Court of Law; established, re-established, monumented, re-monumented, recovered, found as expressed below:

NOTE: Not more than 4 corners, all in the same town and range, may be recorded on this certificate.

	A	B	C	D	E	F	G	H	I	J	K	L	M
2	6		5		4		3		2				
3													
4	7		8		9		10		11		12		
5													
6	18		17		16		15		14		13		
7													
8	19		20		21		22		23		24		
9													
10	30		29		28		27		26		25		
11													
12	31		32		33		34		35		36		
13													

A. Description of original monument and accessories and/or subsequent restoration:


M-10 55-34 & A-10 55-33 SET IN SECTION POST, HEMLOCK 10 S56E 20, HEMLOCK 20 N83W.

M-11 55-34 & A-11 55-33 SE COR. SECTION 25, PREVIOUSLY RECORDED IN L.C.R. LIBER 1, PAGE 569 BY JOHN P. SMALLWOOD, L.S. 16944, 1 1/4" PIPE (O.D.), WITNESSES: 12" CEDAR WEST 44.62', 4" MAPLE N50W 23.31', 7" SPRUCE S22E 12.29', 10" MAPLE S80E 43.04'.

B. Description of corner evidence found and/or method applied in restoring or reestablishing corner:

M-10 55-34 & A-10 55-33 1" PIN (FND IN TRAIL, DATED 1876), REPLACED WITH 1/2" IRON PIPE WITH 2 1/4" BRASS CAP. PREVIOUSLY RECORDED BY R.W. CRAMPTON, LIBER 3, PAGE 259.

M-11 55-34 & A-11 55-33 SE COR. SECTION 25, FOUND 1" PIPE WITH COUPLE & ELBOW, 11" A.G., REPLACED WITH 1/2" IRON PIPE WITH 2 1/2" BRASS CAP. PREVIOUSLY RECORDED BY R.W. CRAMPTON, LIBER 2, PAGE 863.

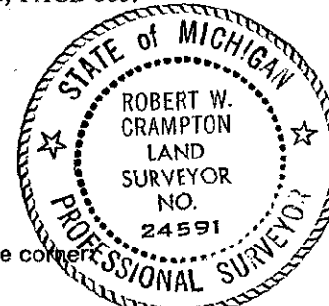

C. Description of monument for corner and accessories established to perpetuate locating the position of the corner:

M-10 55-34 & A-10 55-33 THE 1/2" IRON PIPE WITH BRASS CAP WITNESSED WITH SURVEY TAG NAILED TO: 13" RED PINE TREE N51°E 13.71', 8" WHITE PINE TREE N77°E 13.94', 4" PIN CHERRY TREE S16°E 26.45', 15" RED PINE TREE N28°W 32.13'.

M-11 55-34 & A-11 55-33 SE COR. SECTION 25, 1/2" IRON PIPE WITH BRASS CAP WITNESSED WITH SURVEY TAG NAILED TO: 16" MAPLE TREE S43°E 41.71', MDOT WITNESS: 16" CEDAR TREE S89° W 44.43' (TAG IN SIDE), CRAMPTON # 24591 WITNESSES: (TAG ON FACE) 36" TWIN MAPLE N38°E 19.51', 10" SPRUCE S22°E 11.84'.

Signed by Robert W. Crampton Date AUG. 26, 1997
Surveyor's Michigan License No. 24591