

SEPT 23 1997  
Robert W. Crampton

LAND CORNER RECORDATION CERTIFICATE  
Filing Requirement of Act 74, Mich. P.A. 1970

SURVEY & REMONUMENTATION

For corners in HOUGHTON  
(County)

Located In:

Corner Code #

JAN 09 1998

- 1. Public Land Survey T 55N R 33W  
T 55N R 34W  
T \_\_\_\_\_ R \_\_\_\_\_  
T \_\_\_\_\_ R \_\_\_\_\_
- 2. Property Controlling S \_\_\_\_\_ T \_\_\_\_\_ R \_\_\_\_\_  
in Section S \_\_\_\_\_ T \_\_\_\_\_ R \_\_\_\_\_
- 3. Miscellaneous S \_\_\_\_\_ T \_\_\_\_\_ R \_\_\_\_\_  
Property in Section S \_\_\_\_\_ T \_\_\_\_\_ R \_\_\_\_\_

A-12  
M-12  
\_\_\_\_\_  
\_\_\_\_\_  
\_\_\_\_\_

SECTION  
NANCY FENILI 09/23/97 #  
HOUGHTON COUNTY 14:34  
LC 3/ 427 PAU Fee: 9.00  
Page 1 of 1

Register of Deeds Stamp & File Number

- 4. Lot No. \_\_\_\_\_, Recorded Plat \_\_\_\_\_
- 5. Private Claims \_\_\_\_\_

	A	B	C	D	E	F	G	H	I	J	K	L	M
2	6		5		4		3		2				
3													
4	7		8		9		10		11		12		
5													
6	18		17		16		15		14		13		
7													
8	19		20		21		22		23		24		
9													
10	30		29		28		27		26		25		
11													
12	31		32		33		34		35		36		
13													

I, R.W. CRAMPTON, in a field survey on SEPTEMBER 26, 1986, do hereby certify that under requirements of P.A. 74, Michigan P.A. of 1970, the corner points mentioned in lines 1 and 2 above were in conformance with regulations and rules therefore as required in the current manual of survey instructions of the United States Department of the Interior, Bureau of Land Management or by a decree of a Court of Law and/or that the corner points mentioned in lines 3, 4 and 5 above were in conformance with the rules of the Michigan Board of Professional Surveyors or by a Decree of a Court of Law; established, re-established, monumented, re-monumented, recovered, found as expressed below:


NOTE: Not more than 4 corners, all in the same town and range, may be recorded on this certificate.

A. Description of original monument and accessories and/or subsequent restoration:

A-12 55-33 & M-12 55-34 POST SET - HEMLOCK 6 S25W 29, HEMLOCK 8 N54E 23.

B. Description of corner evidence found and/or method applied in restoring or reestablishing corner:

A-12 55-33 & M-12 55-34 1/2" RE-ROD FOUND WHICH CHECKS WITH SURROUNDING PLATS, SET 3/4" IRON PIPE WITH 2 1/4" BRASS CAP OVER 1/2" RE-ROD. PREVIOUSLY RECORDED BY ROBERT CRAMPTON, LIBER 2, PAGE 311.

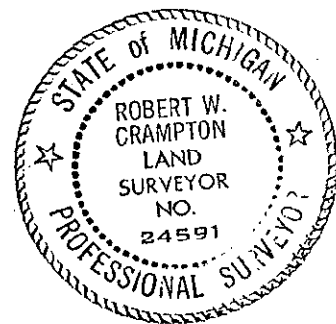

C. Description of monument for corner and accessories established to perpetuate locating the position of the corner:

A-12 55-33 & M-12 55-34 THE 1/2" RE-ROD WITH BRASS CAP WITNESSED WITH SURVEY TAG NAILED TO: UTILITY POLE N3°E 20.24', LIGHT POLE N88°E 36.34', 4" MAPLE TREE S54°E 69.25', 16" MAPLE TREE S83°W 29.36'.

Signed by Robert W. Crampton  
Surveyor's Michigan License No. 24591

Date Aug. 26, 1997