

Robert W. Cranford
Oct. 28, 1999

LAND CORNER RECORDATION CERTIFICATE
Filing Requirement of Act 74, Mich. P.A. 1970

JAN 25 2000

For corners in

Houghton County Located in: Corner Code #

1. Public Land Survey T55N R33N G - 7
 T R
 T R
 T R

2. Property Controlling S T R
 in Section S T R

3. Miscellaneous S T R
 Property in Sec. S T R

4. Lot No. , Recorded Plat

5. Private Claims

Mary Schoos 1P
 Register of Deeds
 Houghton County, Register
 Page 1 of 1 LC 4/48
 PAU Date 12/30/1999 Time 10:34:20
 FFF. 9.00

Register of Deeds Stamp & File Number

	A	B	C	D	E	F	G	H	I	J	K	L	M
1													
2	6	5	4	3	2	1							
3													
4	7	8	9	10	11	12							
5													
6	18	17	16	15	14	13							
7							●						
8	19	20	21	22	23	24							
9													
10	30	29	28	27	26	25							
11													
12	31	32	33	34	35	36							
13													

I, Joseph C. Domitrovich, in a field survey on December 18, 1997, do hereby state that under requirements of P.A. 74, Michigan P.A. of 1970, the corner points mentioned in lines 1 and 2 above were in conformance with regulations and rules therefore as required in the current manual of survey instructions of the United States Department of the Interior, Bureau of Land Management or by a decree of a Court of Law and/or that the corner points mentioned in lines 3, 4 and 5 above were in conformance with the rules of the Michigan Board of Land Surveyors or by a Decree of a Court of Law; established, re-established, monumented, recovered, found as expressed below:

NOTE: Not more than 2 corners, all in the same town and range, may be recorded on this certificate.

A. Description of original monument and accessories and/or subsequent restoration:

(G - 7) Corner Corner Common to Sections 15, 16, 21 & 22, T55N, R33W.

1846 L.S. Scranton set a post with ties:

6" Fir S 38°W 20 links
 12" Black Ash N 51°E 22 links

1918 H.W. Fesing, Engineer, shows this corner and bearing and distances from it to corners North and East. (From field notes in book 38, on file with Steve Hein, P.S., of Laurium)

1997 Joseph C. Domitrovich, P.S. 37273, for Duane Wood, P.S. 24625, found a 3/4" drill rod at this corner. (Part of Houghton County Airport Survey)

B. Description of corner evidence found and/or method applied in restoring or reestablishing corner:

I found no remains of the original corner or accessories. I found the above 3/4" drill rod at the intersection of old fence lines to the East, West and South. I found bearing trees (established by some unknown person) facing the drill rod. Distances to corners North and East work well with Fesing's:


W 1/4 Corner Section 15 N 03°09'47"W 2669.72' (2664.9' Fesing)
 SE Corner section 15 N 88°17'47"E 5353.92' (5358.54' Fesing)

I accepted the drillrod, as found, as the Section Corner

C. Description of monument for corner and accessories established to perpetuate locating the position of the corner:

Corner is a 3/4" drill rod found in place at an old Fence intersection. Ties:

5" cedar S 38°E 10.30' (Found P.K. Nail in side)
 10" Ash S 29°E 37.27'
 14" Dead Elm S 24°W 22.53' (Found P.K. Nail in side)
 3" Hard Maple S 24°W 20.22'
 4" Soft Maple N 62°W 24.35'
 16" Dead Elm N 55°W 28.27' (Found P.K. Nail in side)

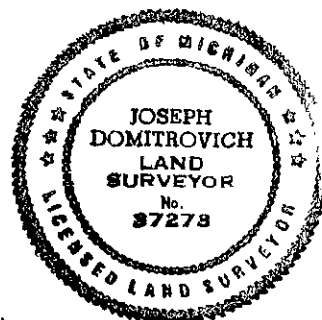

NOTE: Bearings to witness objects are magnetic. Distances are to a nail in side of the witness object unless noted.

Signed by J.C. Domitrovich

Date 10/22/99

Surveyor's Michigan License No. 37273