

Robert W. Camp
Oct. 28, 1999

LAND CORNER RECORDATION CERTIFICATE
Filing Requirement of Act 74, Mich. P.A. 1970

RECORDED

JAN 25 2000

For corners in

Houghton County	Located in:	Corner Code #
1. Public Land Survey	T55N R33W	H - 5
	T R	
	T R	
	T R	
2. Property Controlling in Section	S T R	
	S T R	
3. Miscellaneous Property in Sec.	S T R	
	S T R	
4. Lot No.	Recorded Plat	
5. Private Claims		

SECTION
 Mary Schoos 1P
 Register of Deeds
 Houghton County, Register
 Page 1 of 1 LC 4/49
 PAU Date 12/30/1999 Time 10:34:48
 EEE 9.00

Register of Deeds Stamp & File Number

1	A	B	C	D	E	F	G	H	I	J	K	L	M
2		6	5	4	3	2	1						
3													
4		7	8	9	10	11	12						
5													
6		18	17	16	15	14	13						
7													
8		19	20	21	22	23	24						
9													
10		30	29	28	27	26	25						
11													
12		31	32	33	34	35	36						
13													

I, Joseph C. Domitrovich, in a field survey on October 21, 1999, do hereby state that under requirements of P.A. 74, Michigan P.A. of 1970, the corner points mentioned in lines 1 and 2 above were in conformance with regulations and rules therefore as required in the current manual of survey instructions of the United States Department of the Interior, Bureau of Land Management or by a decree of a Court of Law and /or that the corner points mentioned in lines 3, 4 and 5 above were in conformance with the rules of the Michigan Board of Land Surveyors or by a Decree of a Court of Law; established, re-established, monumented, recovered, found as expressed below:

NOTE: Not more than 2 corners, all in the same town and range, may be recorded on this certificate.

A. Description of original monument and accessories and/or subsequent restoration:

(H - 5) 1/4 Corner common to Sections 10 & 15, T55N, R33W.

1846 L.S. Scranton set a post with ties:

10" Yellow Birch	N 47°W	19 links
12" Fir	S 76°E	42 links

1910 D.W. Holland, field notes and calculation, (on file with Lake Superior Land Co. of Calumet) show a "1 1/4" iron pipe set by Coughlin and ok'ed by D.W. Holland who found Birch B.T. N47°W, 19 links, Fir B.T. not found but roots were found where B.T. was supposed to be." He shows distances to section corners east and west.

1918 H.W. Fesing, Engineer, in field notes (Book 38, on file with Steve Hein, P.S., of Laurium) shows this corner and bearing and distances to section corners East and West. He does not indicate what it is.

B. Description of corner evidence found and/or method applied in restoring or reestablishing corner:

I found No remains of original corner or accessories. Corner now falls in cleared area near the NE end of Houghton County Airport Runway 7-25. At the Corner I found a 1/2" iron pin with cap #24625. This corner was reestablished by Duane Wood, P.S., as part of the Houghton County Airport survey. The corner falls on the extension of centerline of the County Road to the East. Distances to section corners East and West work well with Fesing and Holland's.


NW Corner Section 15	S 88°45'31"W	2694.26'	(2697.64' Fesing)	(2694.95' Holland)
NE Corner Section 15	N 88°32'35"E	2688.69'	(2683.44' Fesing)	(2694.95' Holland)

I accepted the iron pin as the 1/4 corner and placed a 3/4" pipe and cap over it.

C. Description of monument for corner and accessories established to perpetuate locating the position of the corner:

Corner is a 3/4" iron pipe with a brass "Houghton County Remonumentation" cap. Corner falls 104.5' NW (measured at right angle) of the extension of Runway 7-25. Ties:

Brass End of Runway Monument 7-25	S 18°08'53"W	141.56'
P.K. @ intersection of centerlines of Runways	S 62°54'34"W	2128.30'
P.K. in Pavement in centerline, NE end of Runway 7-25	S 46°16'21"W	312.91'
Center of Manhole off Westerly End of County Road	N 86°46'E	904.4'
No other ties available.		

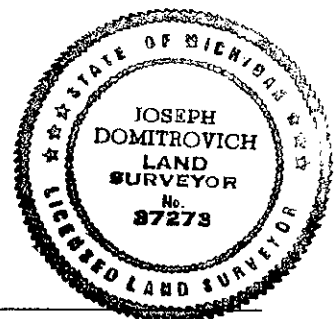

NOTE: Bearings to witness objects are magnetic. Distances are to a nail in side of the witness object unless noted.

Signed by *J.C. Domitrovich*

Date 10/22/99

Surveyor's Michigan License No. 37273