

Robert W. Cranton
Oct. 28, 1999

LAND CORNER RECORDATION CERTIFICATE
Filing Requirement of Act 74, Mich. P.A. 1970

JAN 25 2000

For corners in

- | | | |
|------------------------------------|-------------|---------------|
| Houghton County | Located in: | Corner Code # |
| 1. Public Land Survey | T55N R33W | H - 7 |
| | T R | |
| | T R | |
| 2. Property Controlling in Section | S T R | |
| | S T R | |
| 3. Miscellaneous Property in Sec. | S T R | |
| | S T R | |
| 4. Lot No. , Recorded Plat | | |
| 5. Private Claims | | |

SECTION

Mary Schoos 1P
 Register of Deeds
 Houghton County, Register
 Page 1 of 1 LC 4/50
 PAU Date 12/30/1999 Time 10:35:25
 9.000

Register of Deeds Stamp & File Number

	A	B	C	D	E	F	G	H	I	J	K	L	M
1													
2	6	5	4	3	2	1							
3													
4	7	8	9	10	11	12							
5													
6	18	17	16	15	14	13							
7													
8	19	20	21	22	23	24							
9													
10	30	29	28	27	26	25							
11													
12	31	32	33	34	35	36							
13													

I, Joseph C. Domitrovich, in a field survey on October 20, 1997, do hereby state that under requirements of P.A. 74, Michigan P.A. of 1970, the corner points mentioned in lines 1 and 2 above were in conformance with regulations and rules therefore as required in the current manual of survey instructions of the United States Department of the Interior, Bureau of Land Management or by a decree of a Court of Law and /or that the corner points mentioned in lines 3, 4 and 5 above were in conformance with the rules of the Michigan Board of Land Surveyors or by a Decree of a Court of Law; established, re-established, monumented, recovered, found as expressed below:

NOTE: Not more than 2 corners, all in the same town and range, may be recorded on this certificate.

A. Description of original monument and accessories and/or subsequent restoration:

(H-7) 1/4 Corner Common to Sections 15 & 22, T55N, R333W

1846 L.S. Scranton set a post with ties:

- | | | |
|------------------|--------|--------------------|
| 4" Fir | S 66°E | 9 links |
| 12" Yellow Birch | N 34°W | (Distance omitted) |

1918 H.W. Fesing, Engineer, calculated a position for this corner using single proportionate measurement but does not indicate that he set the corner. (From Fesing Notes in Fieldbook #38 on file with Steve Hein P.S. in Laurium.)

1997 Joseph C. Domitrovich, P.S. 37273, for Duane Wood, P.S. 24625, re-established this corner by single proportionate measurement as part of the Houghton County Airport survey. A 1/2" x 36" iron pin, encased in a 4" diameter concrete monument was placed at the corner position.

B. Description of corner evidence found and/or method applied in restoring or reestablishing corner:

I recovered the above concrete monument. Distances to section corners east and west work well with calculated H.W. Fesing distances.


- | | | | | |
|----------------------|--------------|-------------|-------------------|----------------|
| SE corner Section 15 | N 88°17'47"E | 2676.96' m. | (2679.22' Fesing) | (2616.24' GLO) |
| SW corner Section 15 | S 88°17'47"W | 2676.96' m. | (2679.32' Fesing) | (2616.24' GLO) |

I accepted the Concrete Monument as the 1/4 corner.

C. Description of monument for corner and accessories established to perpetuate locating the position of the corner:

Corner is a 1/2" x 36" iron pin encased in a 4" diameter concrete monument. The corner falls at the top of a ravine that slopes to the South. A wandering E - W fenceline falls 12' +/- North of the corner. Ties:

- | | | |
|-----------------|--------|--------|
| 12" Soft Maple | N 77°E | 8.97' |
| 3" Cedar | East | 2.57' |
| 4" White Birch | N 64°W | 24.72' |
| 6" Yellow Birch | N 25°W | 23.44' |

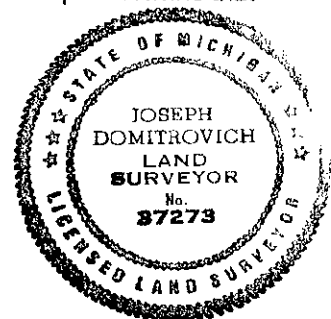

NOTE: Bearings to witness objects are magnetic. Distances are to a nail in side of the witness object unless noted.

Signed by Joseph C. Domitrovich

Date 10/22/99

Surveyor's Michigan License No. 37273